
90684

T.9S., R.2E., W.M.

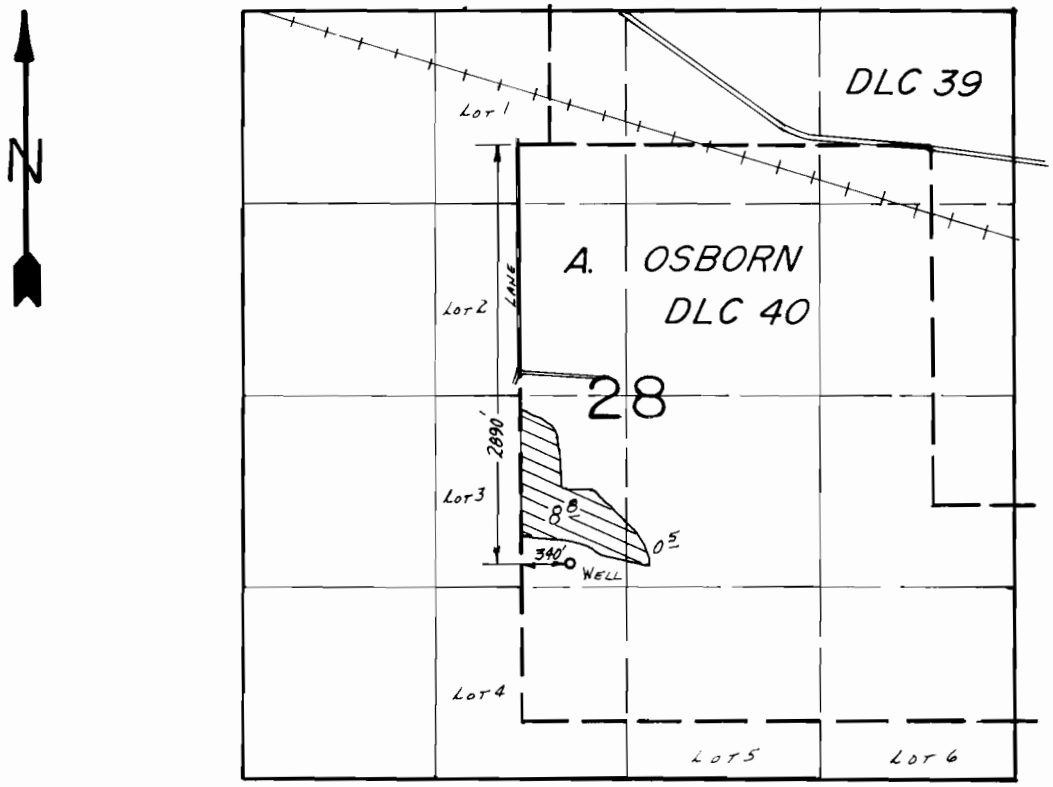

SCALE: 1" = 1320'

FINAL PROOF SURVEY

UNDER

Application No. G-10180 **Permit No.** G-9713

IN NAME OF

THOMAS W. BONEBRAKE

Surveyed Sept. 5 **19** 85, **by** T. M. WARREN

41043-178-40A 11/26/86 TMW BWB