


T. 33 S., R. 44 E., W. M.

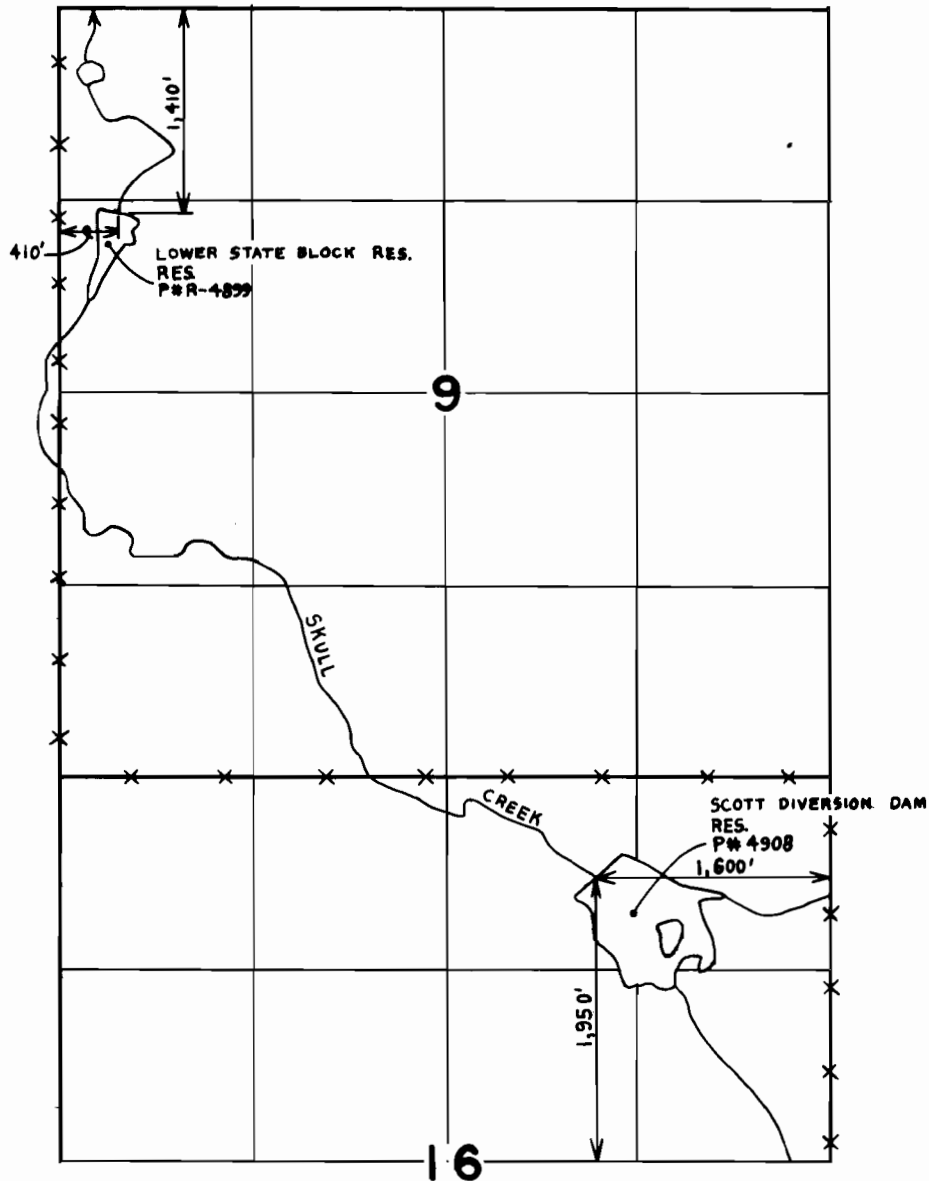

FINAL PROOF SURVEY
UNDER

R-43105 R-4908
Application No. ~~R-43021~~ Permit No. ~~R-4899~~.....
IN NAME OF

RALPH EASON

Surveyed JULY 17, 1985, by L. TOLL.....