


T.31S., R.41&42E., W.M.

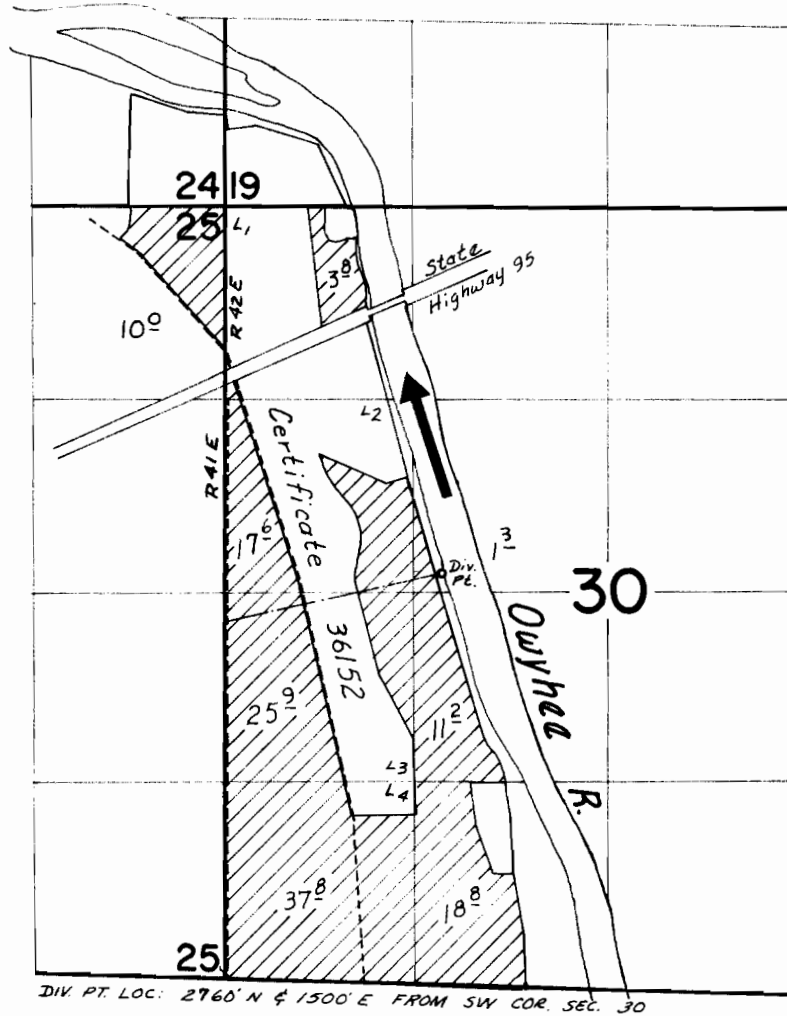

DIV. PT. LOC: 2760' N & 1500' E FROM SW COR. SEC. 30

FINAL PROOF SURVEY
UNDER

Application No. **43343** Permit No. **36110**
IN NAME OF

RALPH EASON

Surveyed July 14 1975, by D. Norby