


T.29S.,R.46E.,W.M.

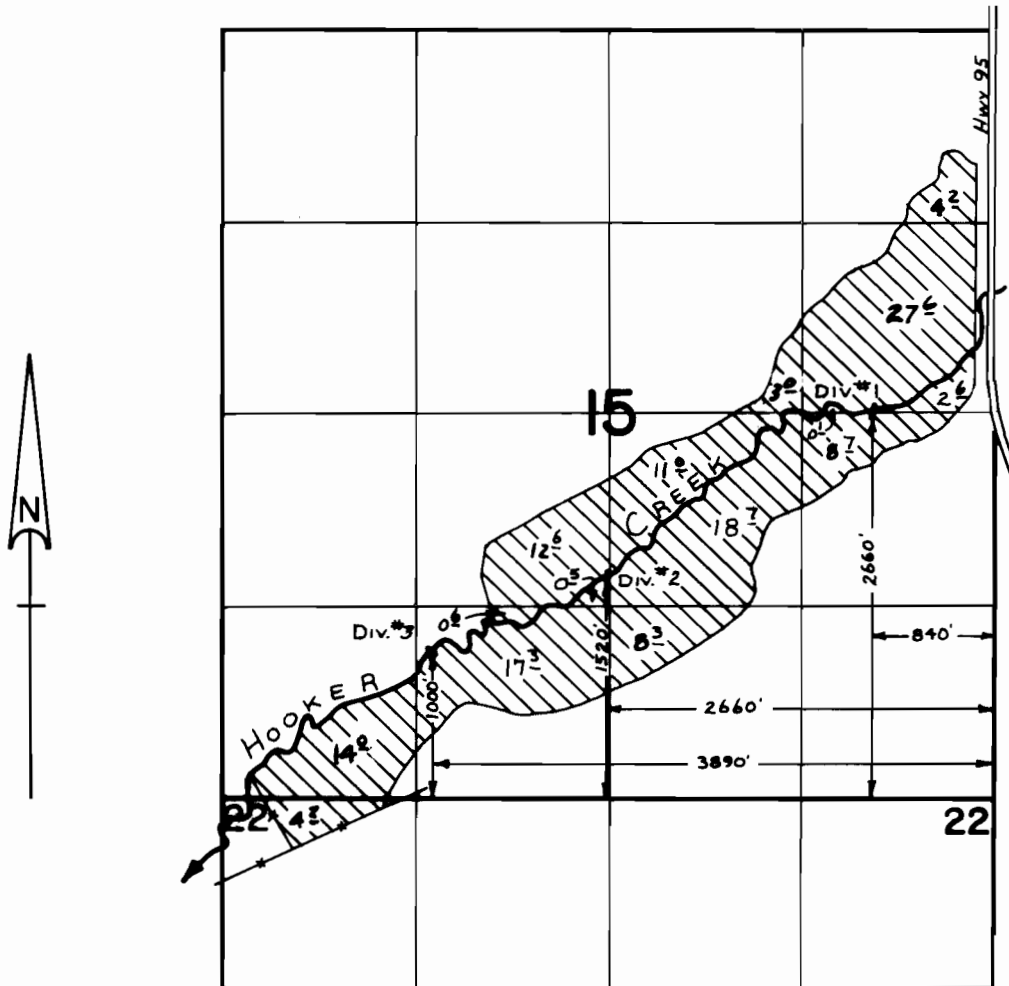

SCALE: 1" = 1320'

FINAL PROOF SURVEY
UNDER

Application No. 49397 Permit No. 37022.....
IN NAME OF

BILL E. ROSS.....

Surveyed Oct. 18, 1985, by L. M. TOLL.....