


T. 33 S., R. 40 E., W. M..

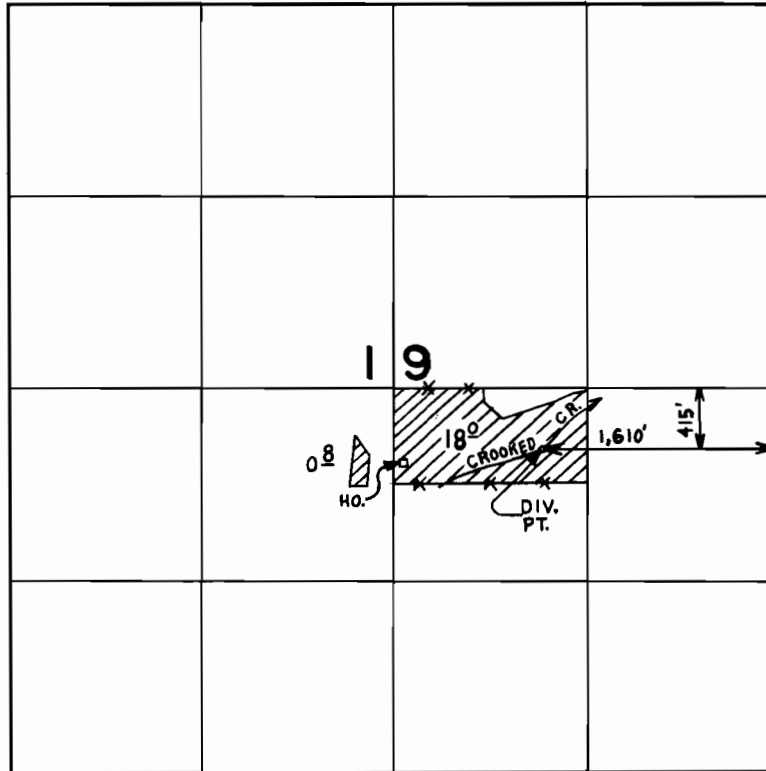

SCALE: 4"=1 mile

FINAL PROOF SURVEY
UNDER

Application No. ~~52649~~ Permit No. ~~38640~~.....
IN NAME OF

LORETTA FRETWELL & JUDITH L. McELVAIN

Surveyed JULY 18, 1985, by L. TOLL.....