


T. 14 S., R. 39 E., W. M.

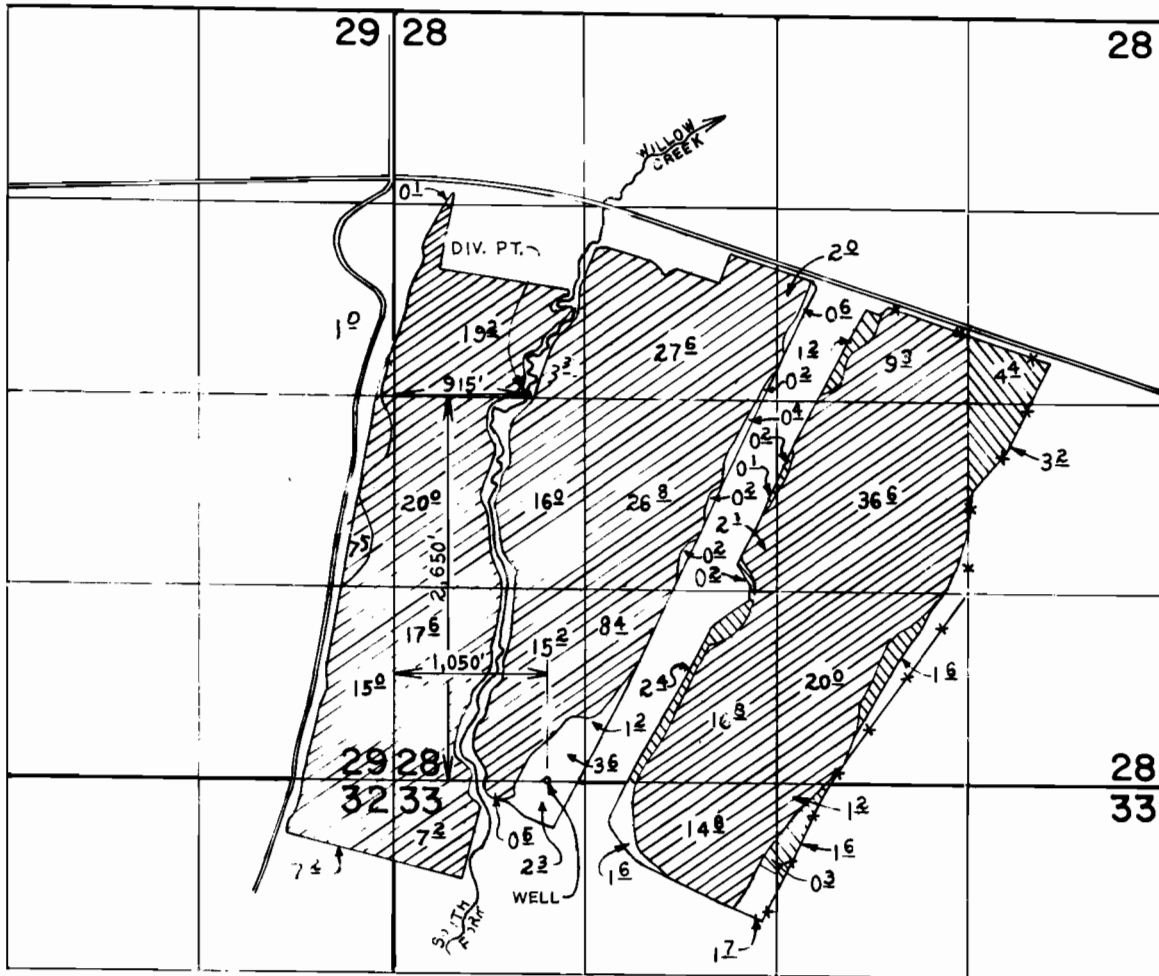

▨ P#G-7418

▨ P#46371

SCALE: 4" = 1 mile

FINAL PROOF SURVEY

UNDER

61235

46371

Application No. G-7996.. Permit No. G-7418.....

IN NAME OF

RAYMOND M. & V. FERNE DUNCAN.

Surveyed SEPT. 3. 1985., by L. TOLL.....