


# T. 14 S., R. 39 E., W. M.

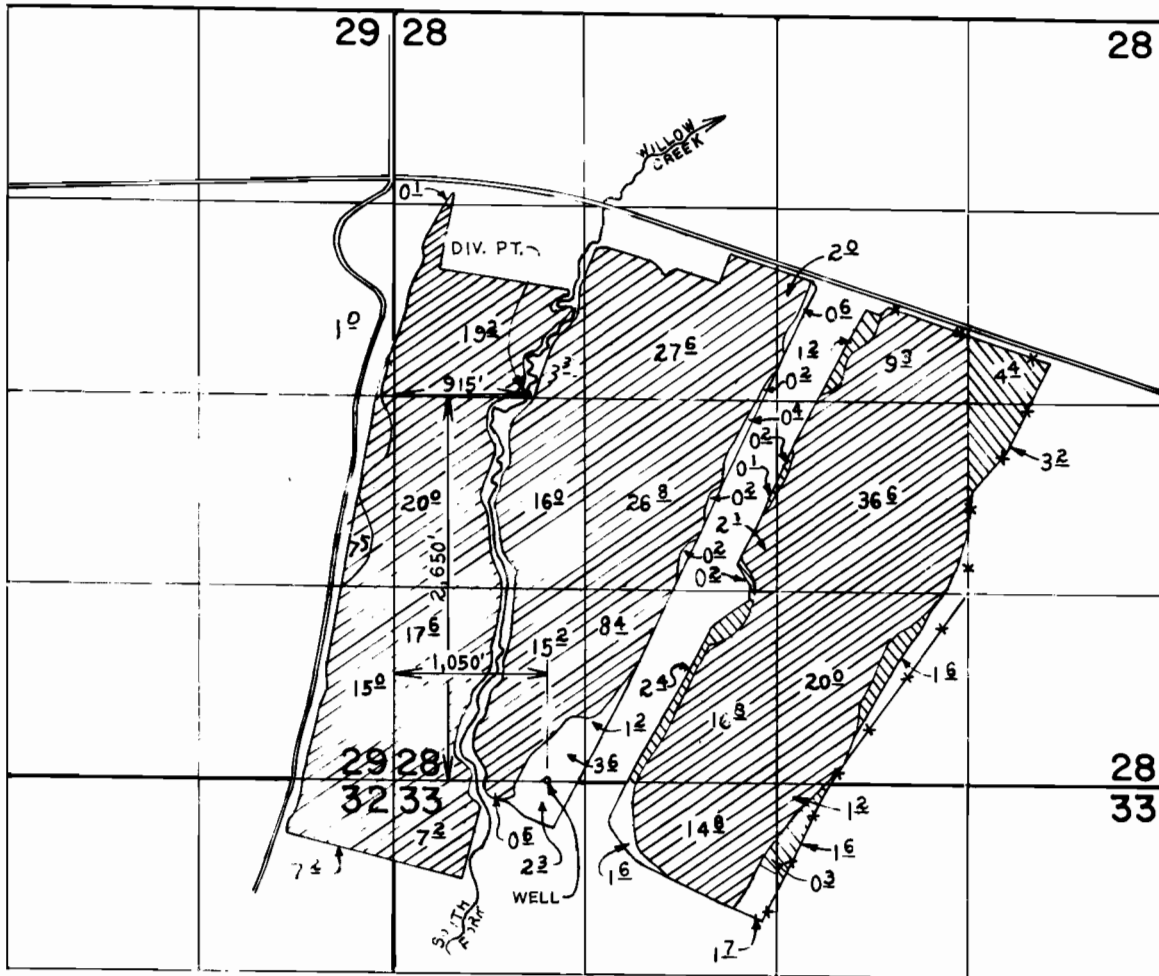

▨ P#G-7418

▨ P#46371

SCALE: 4" = 1 mile

## FINAL PROOF SURVEY

UNDER

61235

46371

Application No. G-7996.. Permit No. G-7418.....

IN NAME OF

**RAYMOND M. & V. FERNE DUNCAN.**

Surveyed SEPT. 3, 1985., by L. TOLL.....