
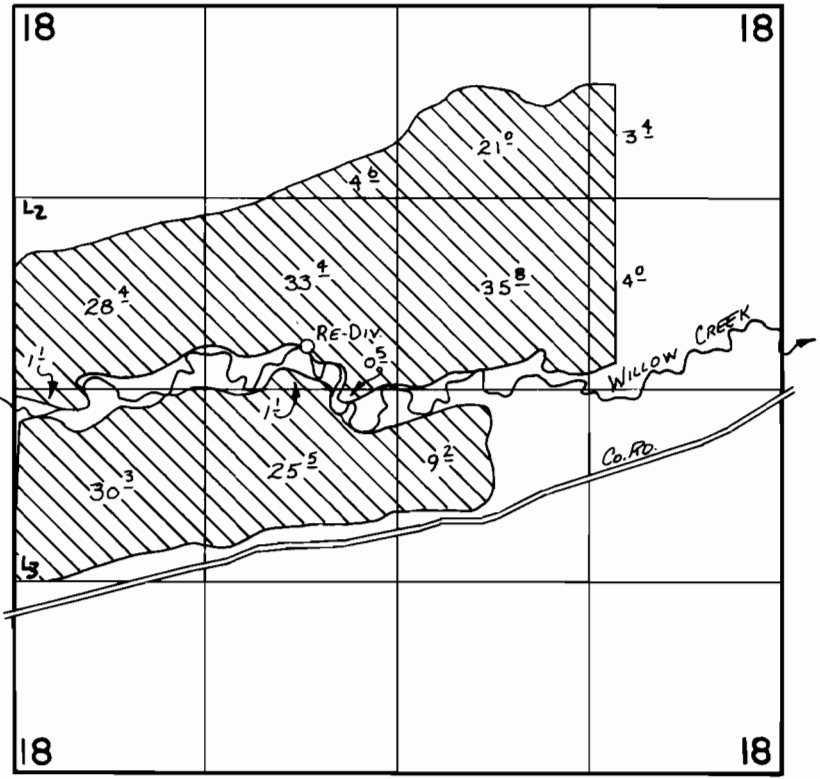


T.14S.,R.39E.,W.M.

T.14S.,R.40E.,W.M.

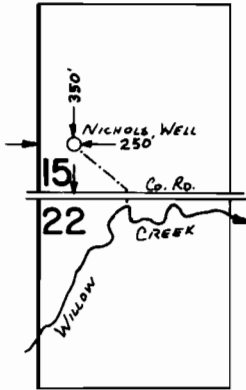

SCALE: 1" = 1320'

FINAL PROOF SURVEY UNDER

Application No. G-7895, Permit No. G-7389.....
IN NAME OF

.....DONALD OAKS.....

Surveyed Aug. 23, 1985, by L. M. TOLL.....

LMT