


T. 31 S., R. 41 E., W. M..

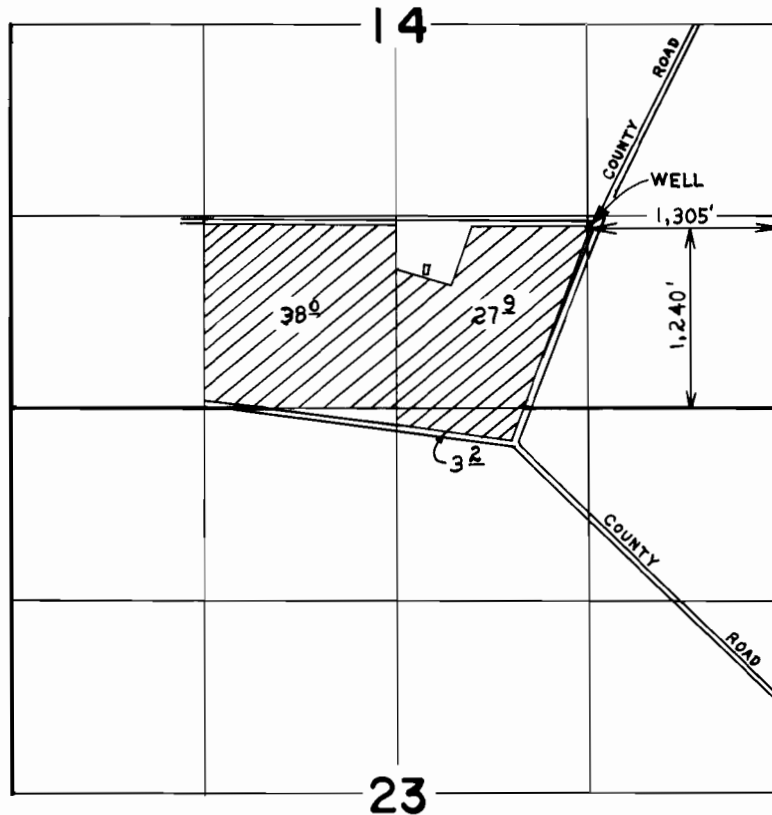

SCALE: 4"=1 mile

FINAL PROOF SURVEY
UNDER

Application No. G-7203. Permit No. G-7986.....
IN NAME OF

MARVIN A. EASTERDAY

Surveyed JULY 16, 1985, by L. TOLL.....