



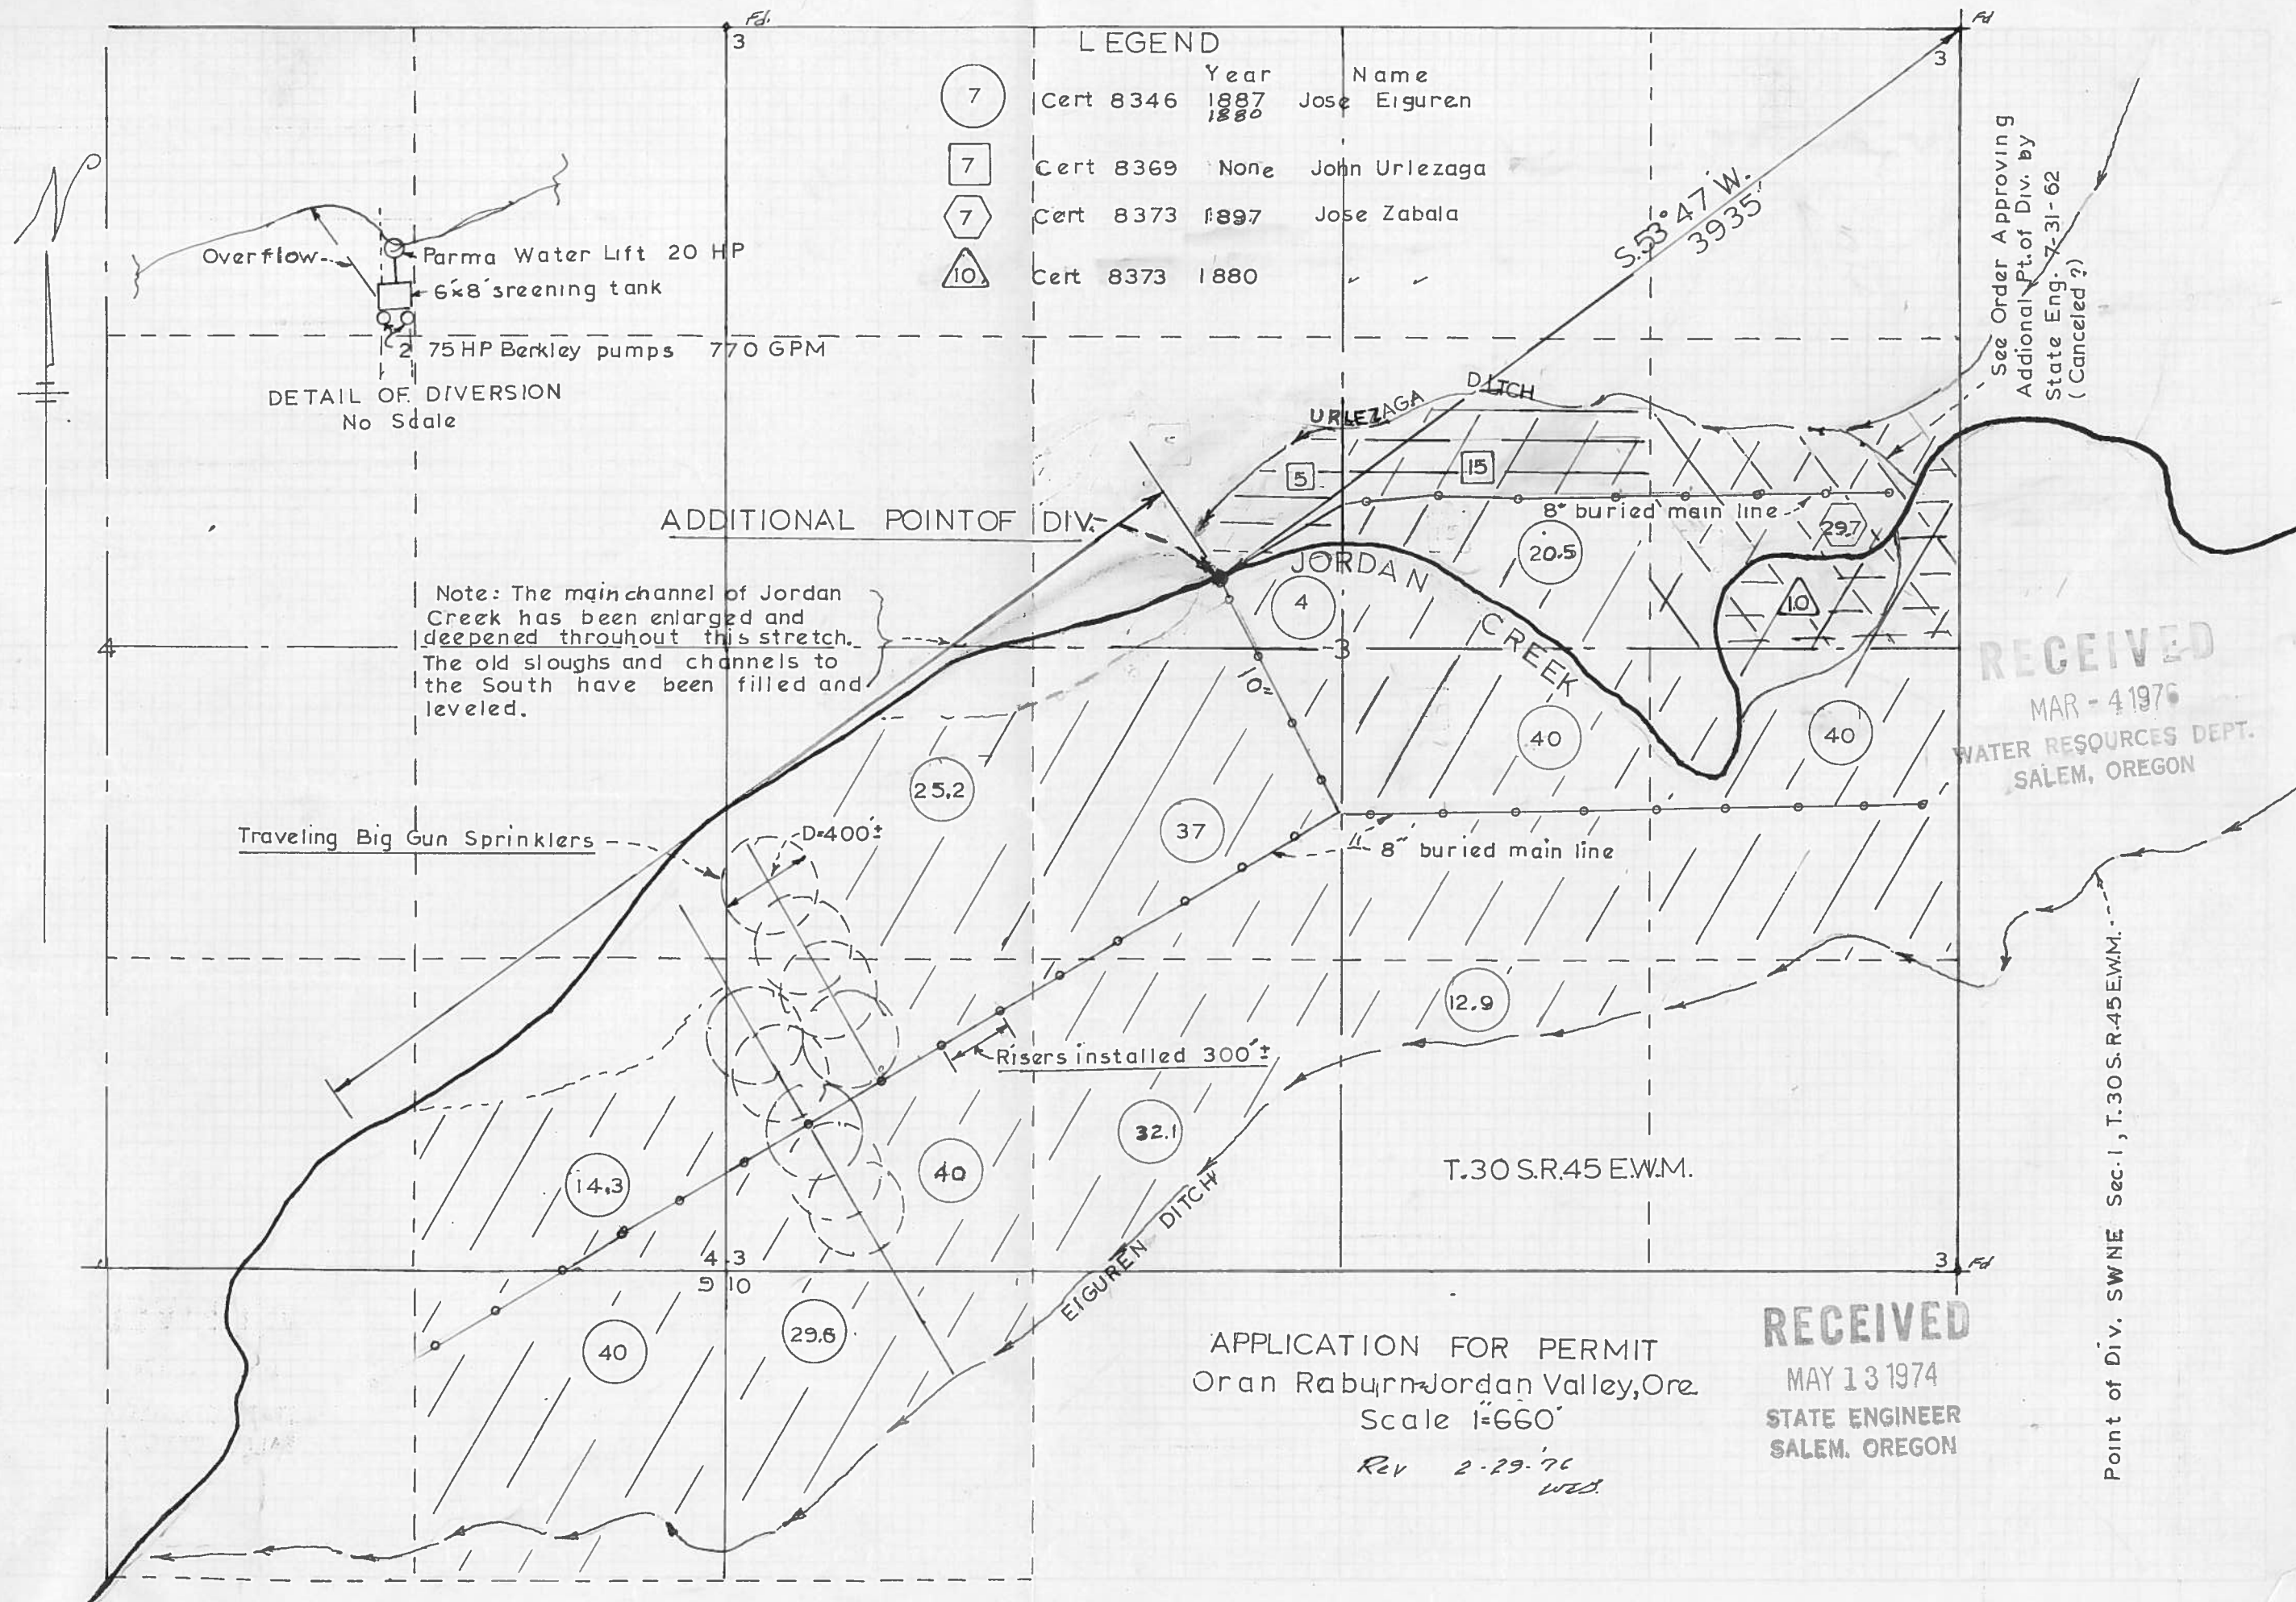

T.30S.,R.45E.,W.M.

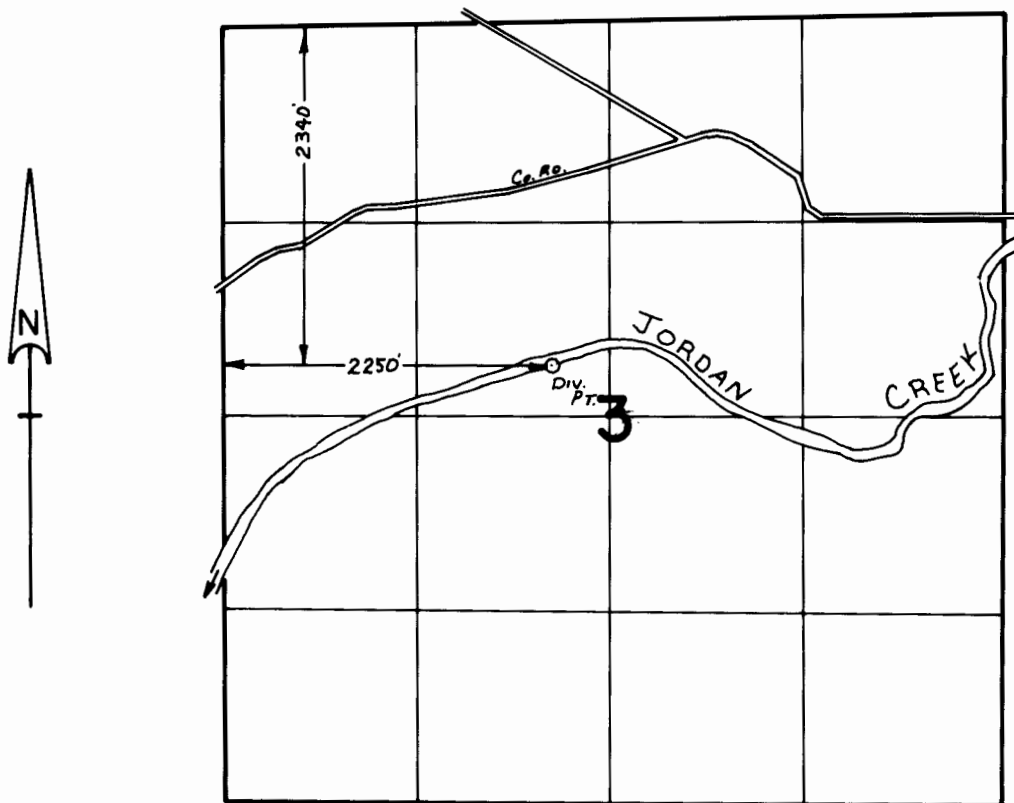

SCALE: 1" = 1320'

FINAL PROOF SURVEY
UNDER

Transfer No. 3040
Application No. Permit No.
IN NAME OF

..... **ORAN RABURN**

Surveyed July 26, 1985, by L. M. TOLL