


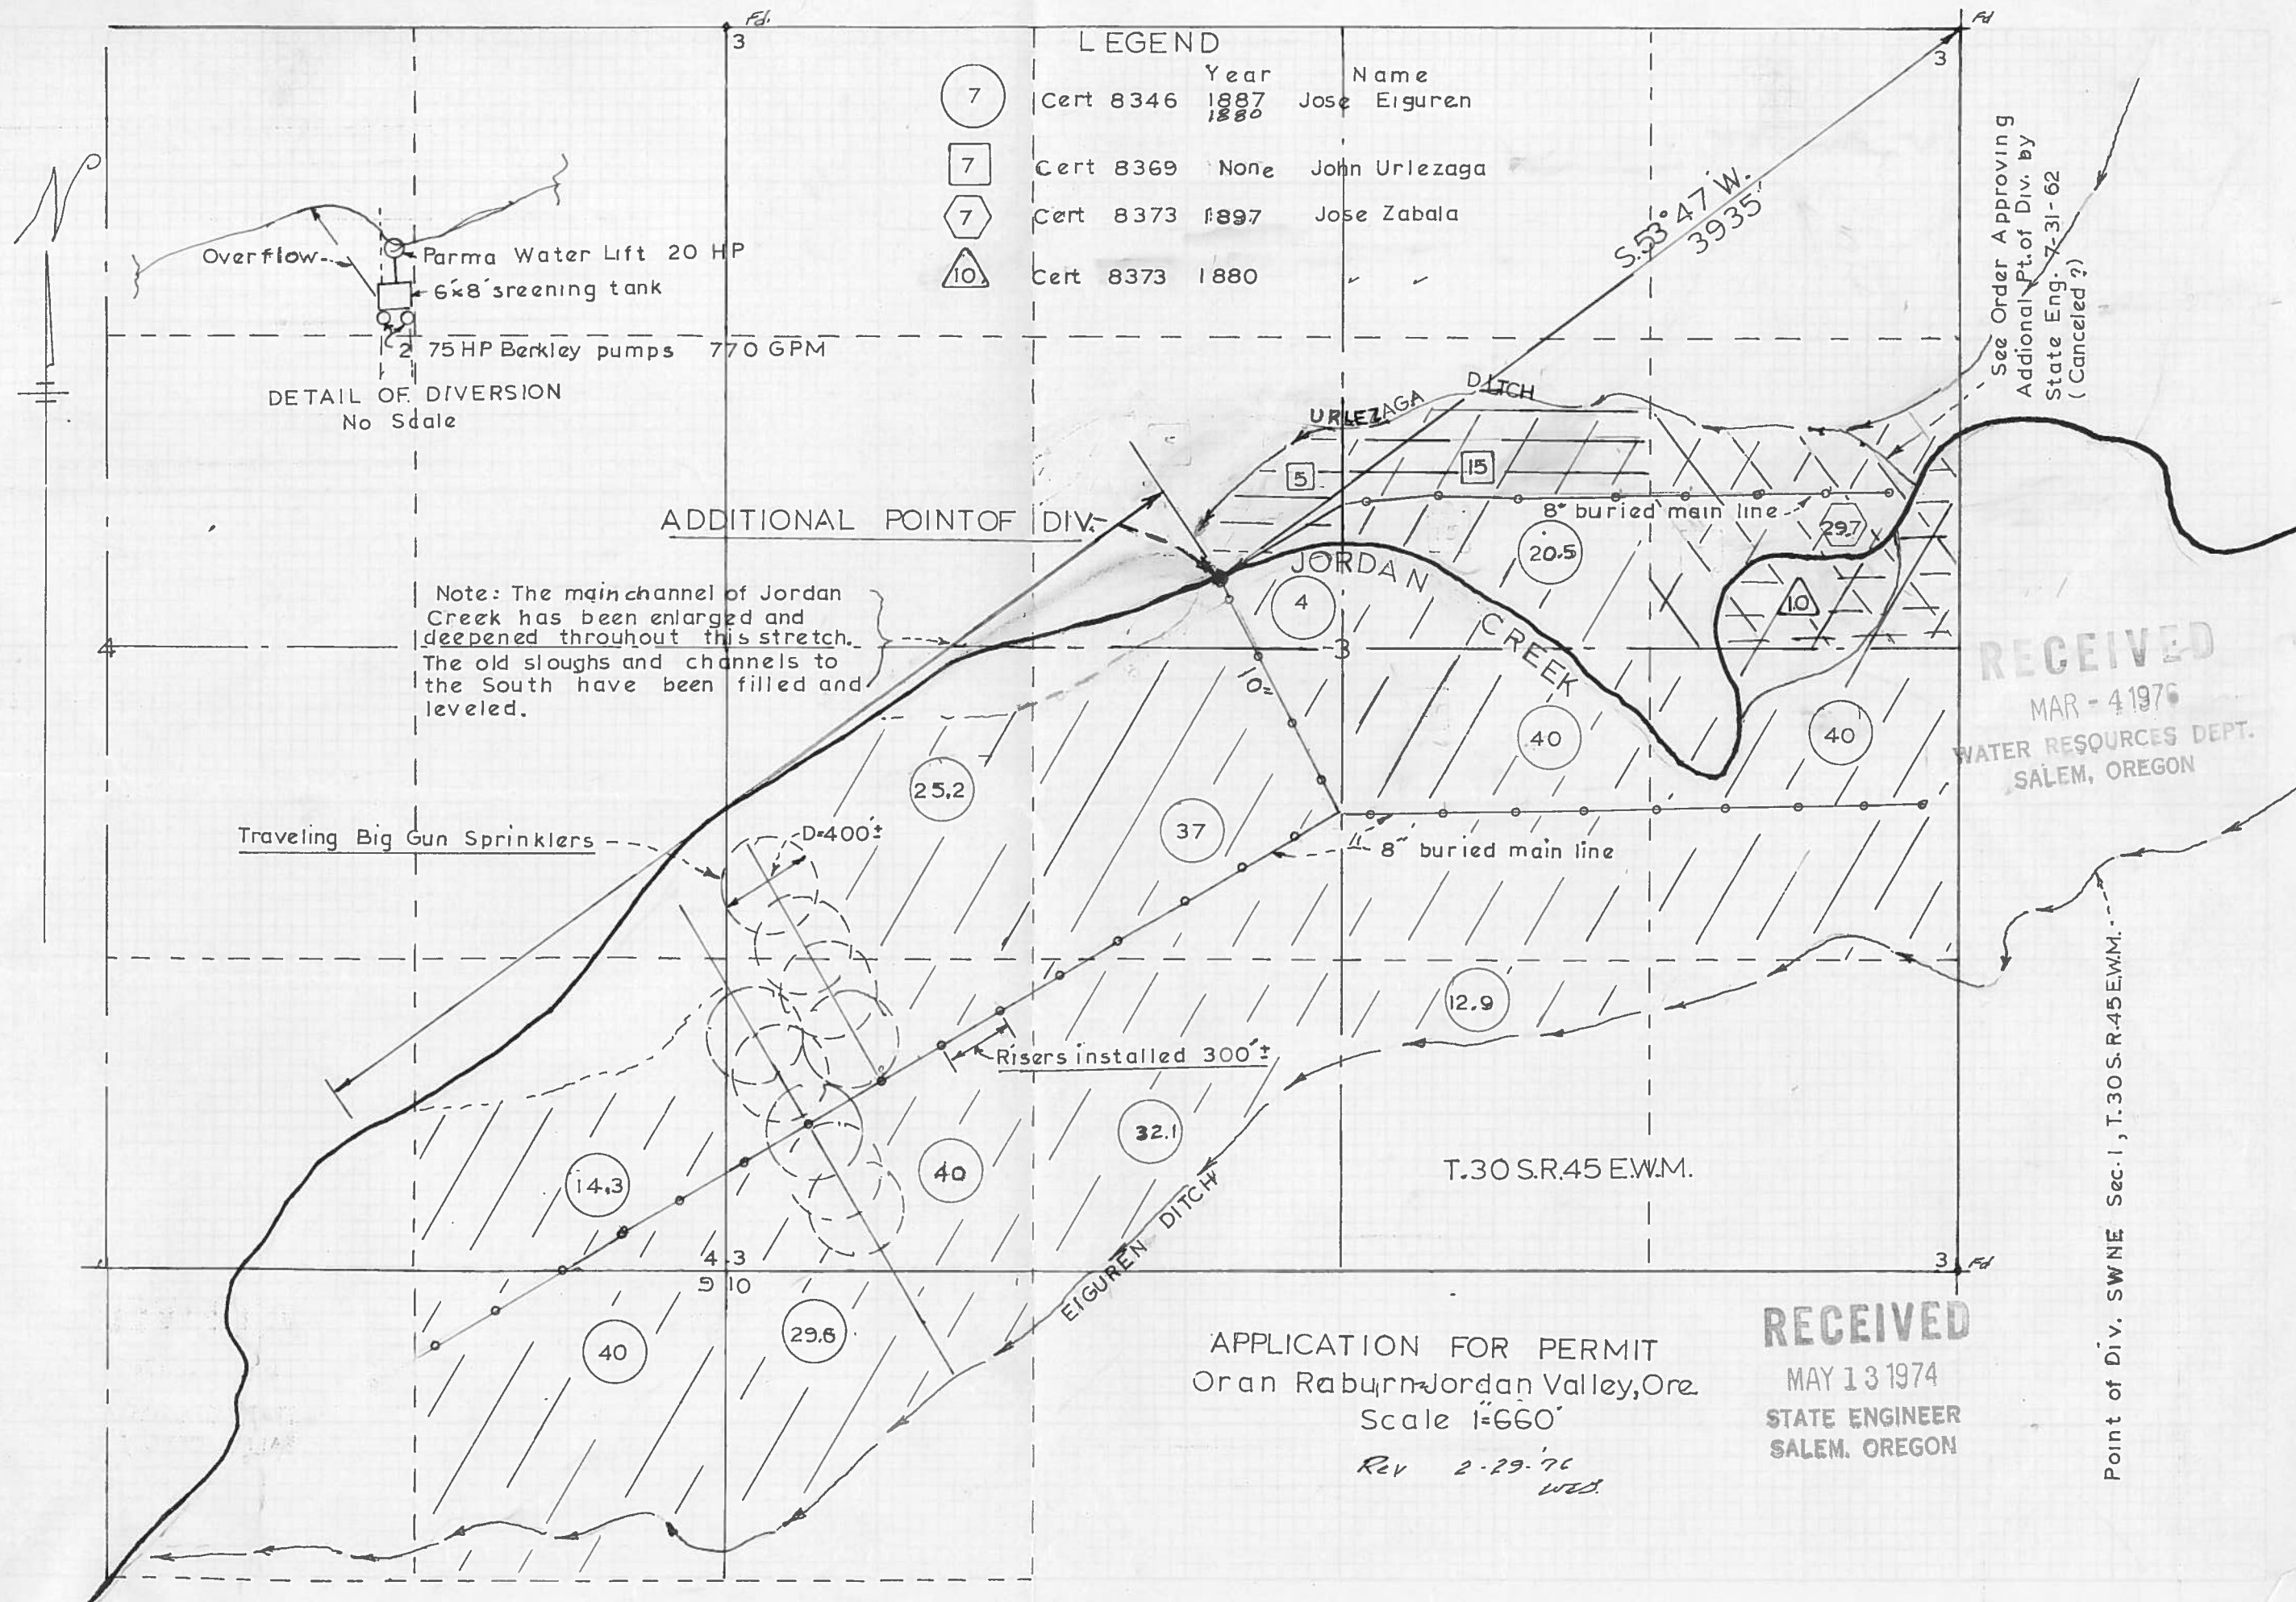


RECEIVED
MAR - 4 1976
WATER RESOURCES DEPT.
SALEM, OREGON

APPLICATION FOR PERMIT
Oran Raburn Jordan Valley, Ore.
Scale 1"=660'
Rev 2-29-76
WED.

RECEIVED
MAY 13 1974
STATE ENGINEER
SALEM, OREGON

T.30S.,R.45E.,W.M.

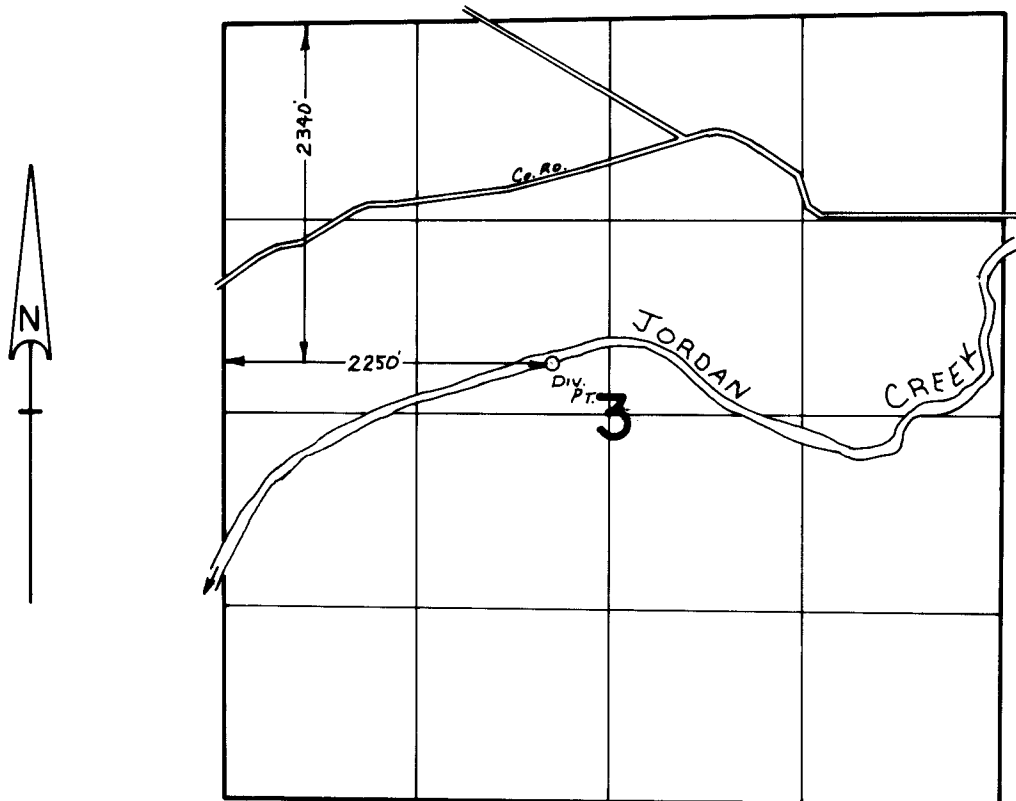

SCALE: 1" = 1320'

FINAL PROOF SURVEY
UNDER

Transfer No. 3040
Application No. Permit No.
IN NAME OF

..... **ORAN RABURN**

Surveyed July 26, 1985, by L. M. TOLL