


T.6S. R.1W., W.M.

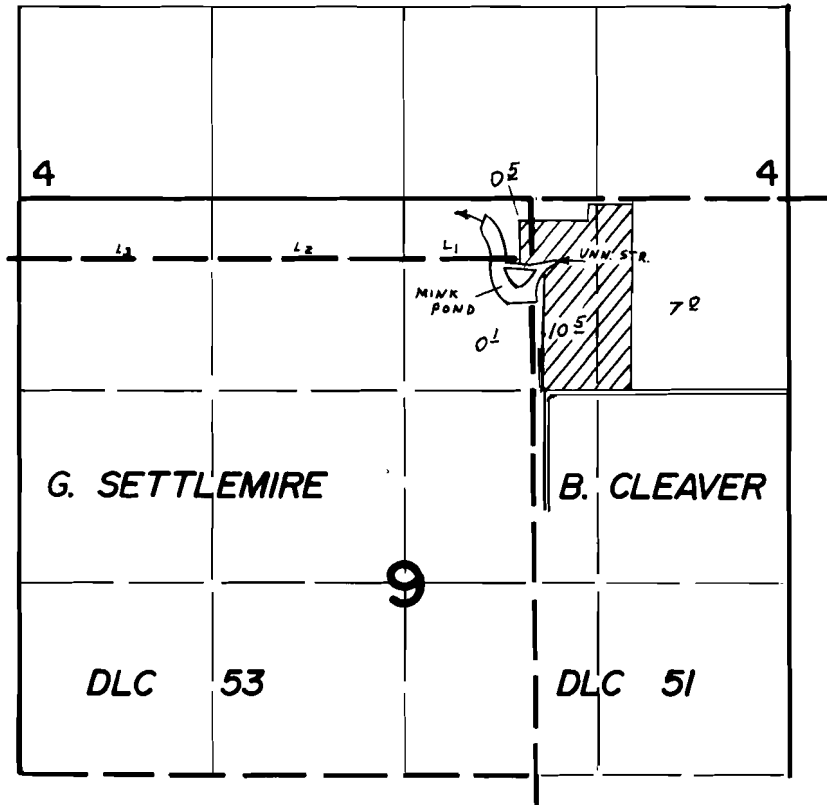

Div. Pt. Loc. 150' S. of 330' W. From N.W. Cor. DLC 51

FINAL PROOF SURVEY UNDER

R-54841 R-6565
 Application No. ~~54842~~ Permit No. ~~41357~~
 IN NAME OF

.....RUEF'S FUR RANCH.....

Surveyed JUNE 6, 1979, by L. H. NUNN.....