


T.9S.R.1W.W.M.

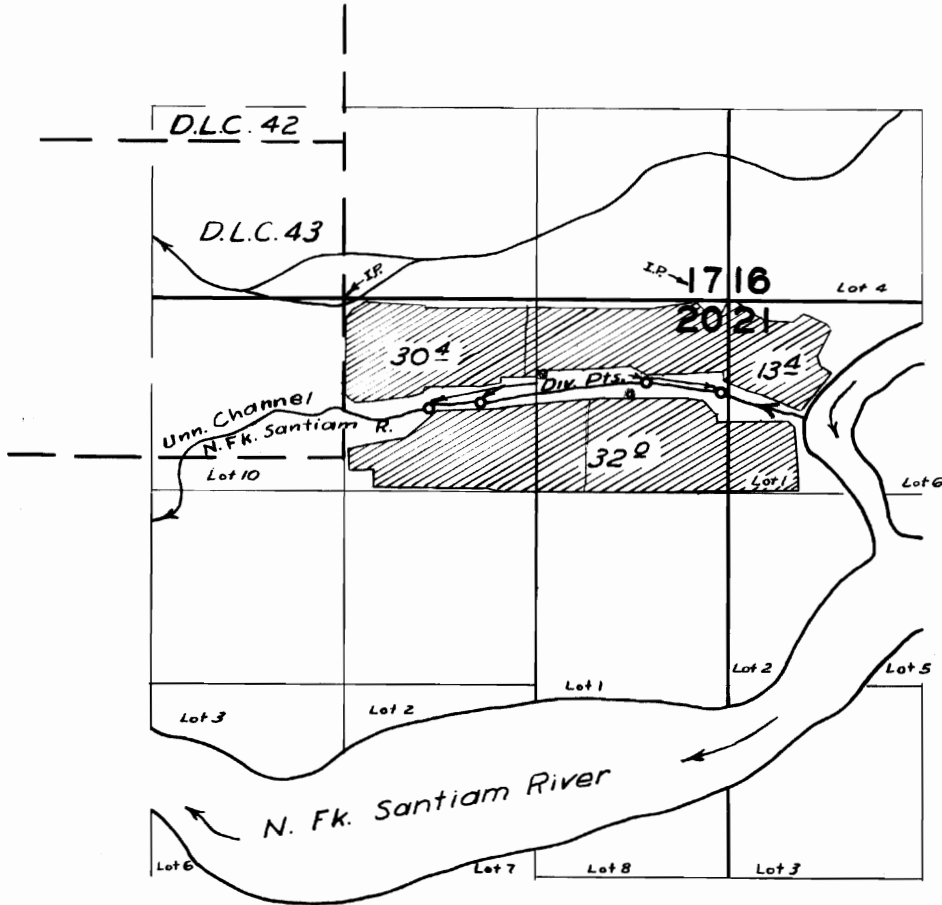

FINAL PROOF SURVEY UNDER

Application No. 27362 Permit No. 21543
IN NAME OF

ERNEST H. LAFKY

Surveyed 3 Nov. 1959, by M. Bish