


# T. 7 S. R. 2 W., W.M.

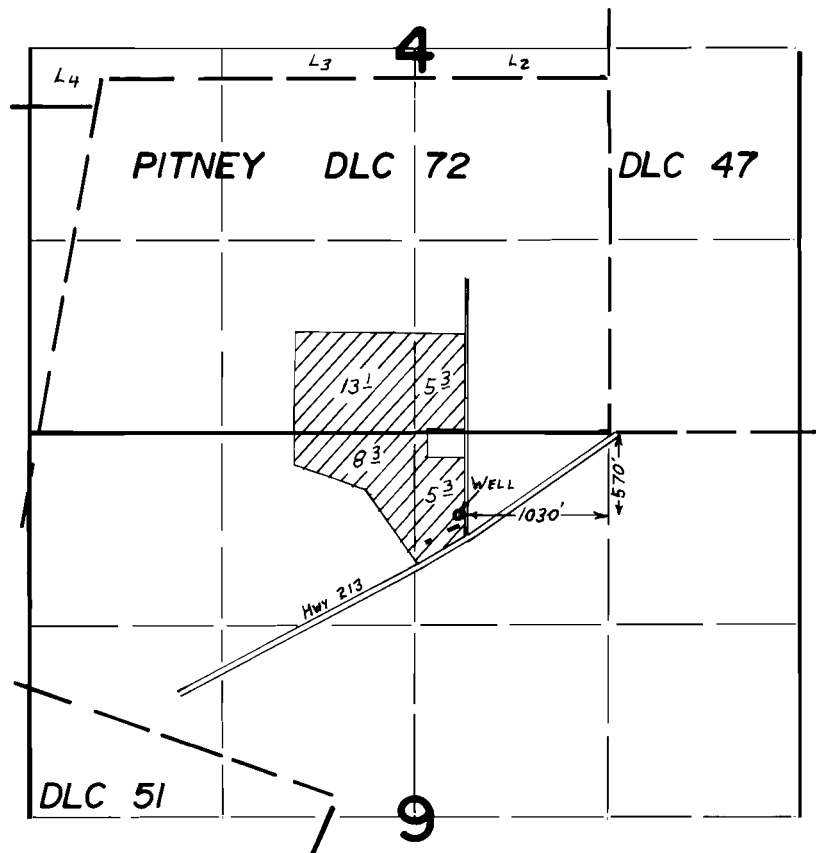

## FINAL PROOF SURVEY UNDER

Application No. G-5587.. Permit No. G-5444.....  
IN NAME OF

.....MARVIN E. CAGE.....

Surveyed MAY...31... 1979., by L.H. NUNN.....