


T.5S. R.2W. W.M.

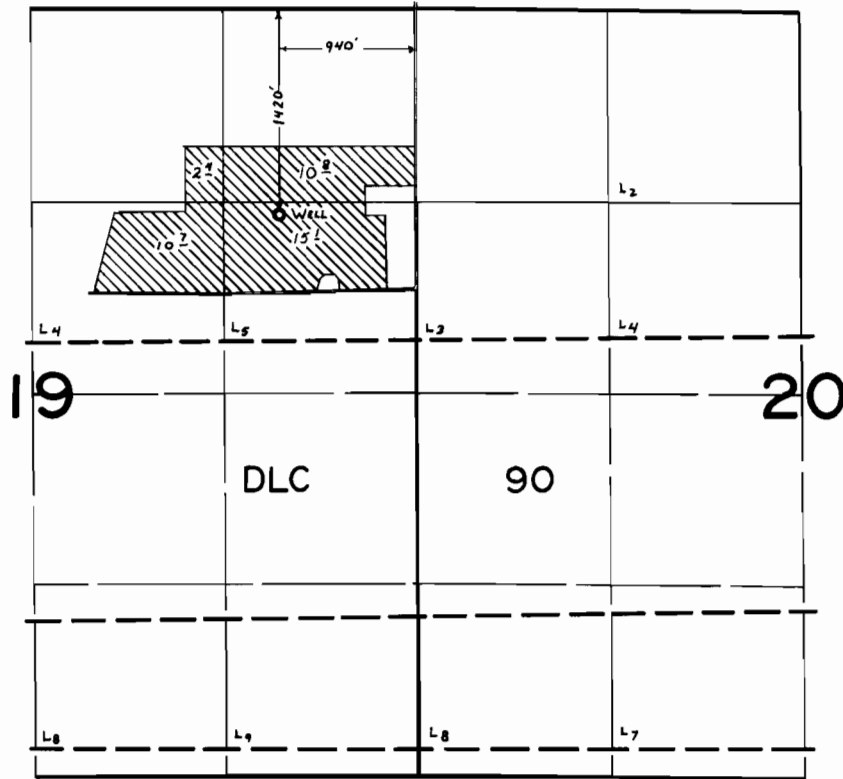

FINAL PROOF SURVEY UNDER

Application No. G-6612. Permit No. G-6193.....
IN NAME OF

.....NORMAN NIBLER.....

Surveyed July 3, 1980, by C. L. Hughes.....