


# T.5S. R.1W. W.M.

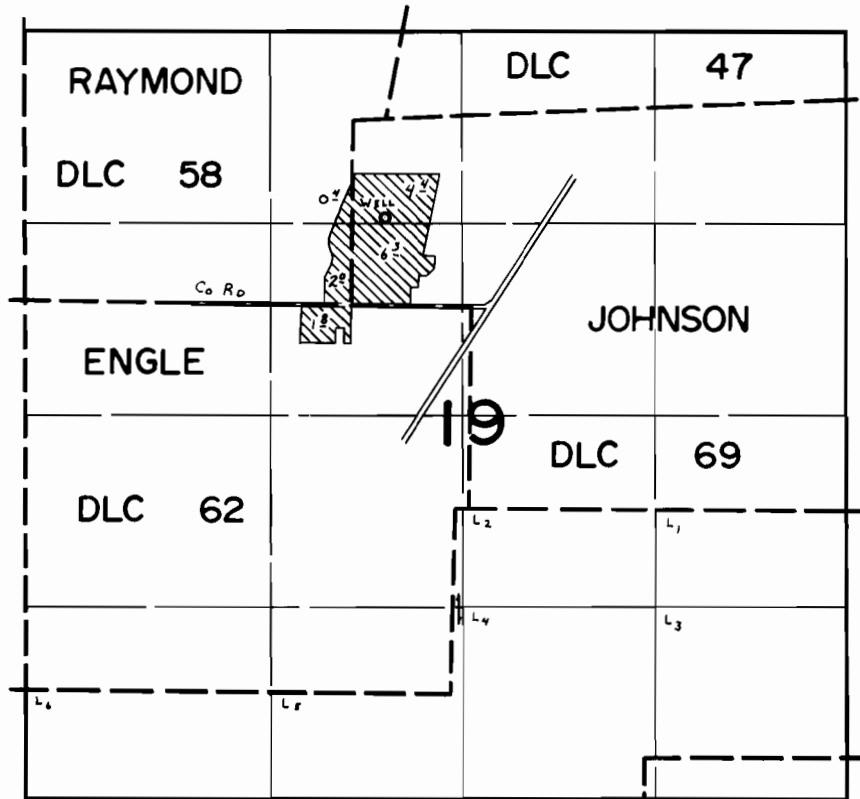

WELL Loc: 670'S. § 220' E. fr. N.W. Cor. JOHNSON DLC 69.

## FINAL PROOF SURVEY UNDER

Application No. G-67111. Permit No. G-6252....  
IN NAME OF

BELLE PASSI CEMETERY ASSOCIATION

Surveyed June 30, 1980, by C.L. Hughes.....