


T.9S. R.2W., W.M.

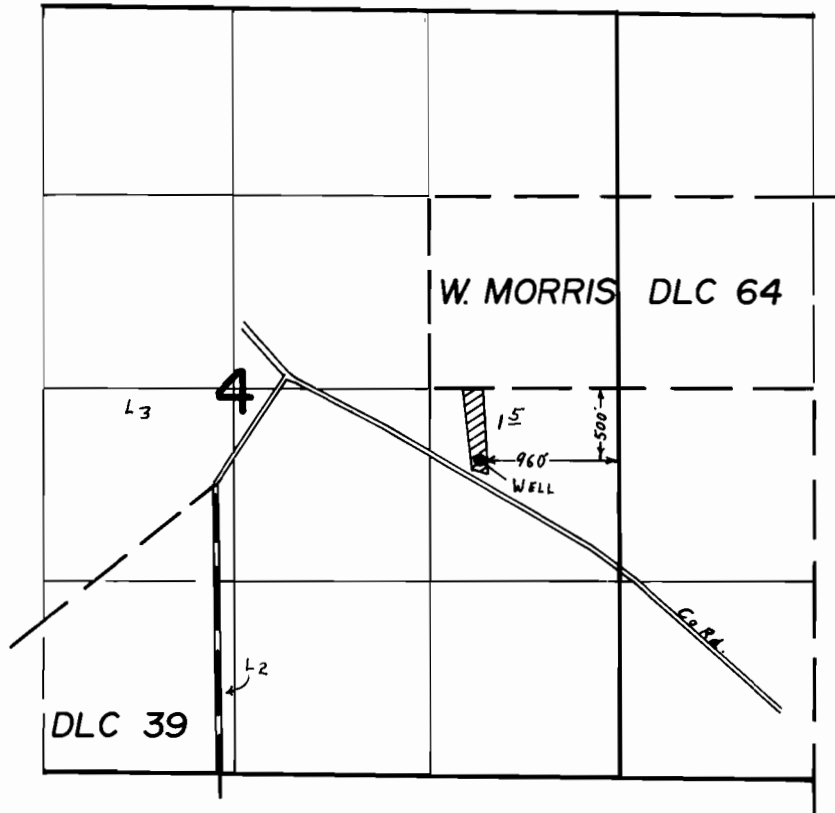

FINAL PROOF SURVEY UNDER

Application No. ~~G-6859~~ Permit No. ~~G-6398~~.....
IN NAME OF

.....ANNABELL RUNIONS.....

Surveyed MAY...29... 1979., by L. H. NUNN.....