


T.6S. R.2W., W.M.

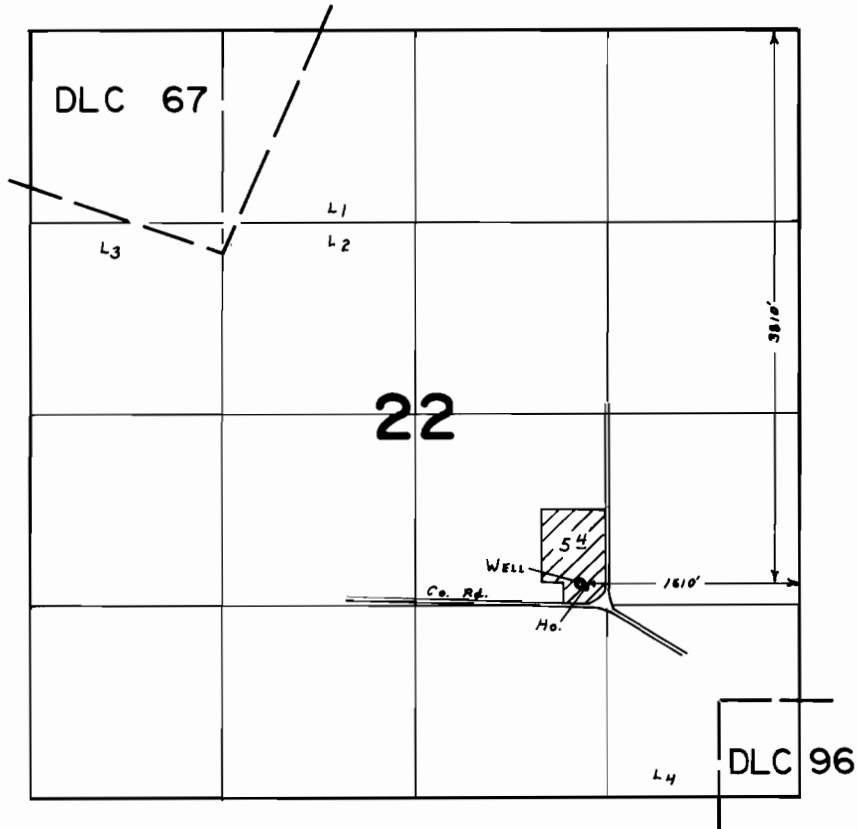

FINAL PROOF SURVEY UNDER

Application No. G-6961.. Permit No. G-6473.....
IN NAME OF

.....WILEY BIGGINS.....

Surveyed APR. 25.. 1979., by L. H. NUNN.....