


# T. 6S. R. 1W. W.M.

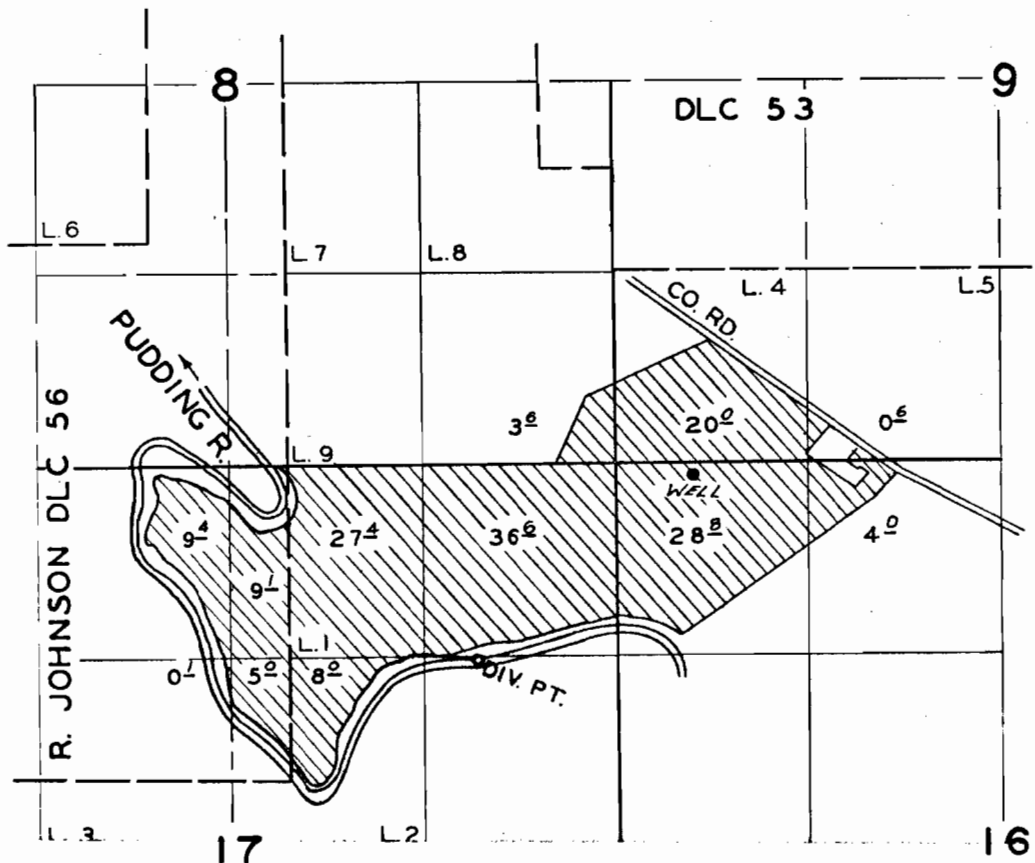

Well Loc. - 80'S & 540'E from NW Cor. Sec. 16

## FINAL PROOF SURVEY UNDER

Application No. G-8230 Permit No. G-7573  
IN NAME OF

J. B. M. FARM Co.

Surveyed Oct. 2, 1979, by C. R. RODRIGUEZ