


T. 4S., R. 1W., W.M.

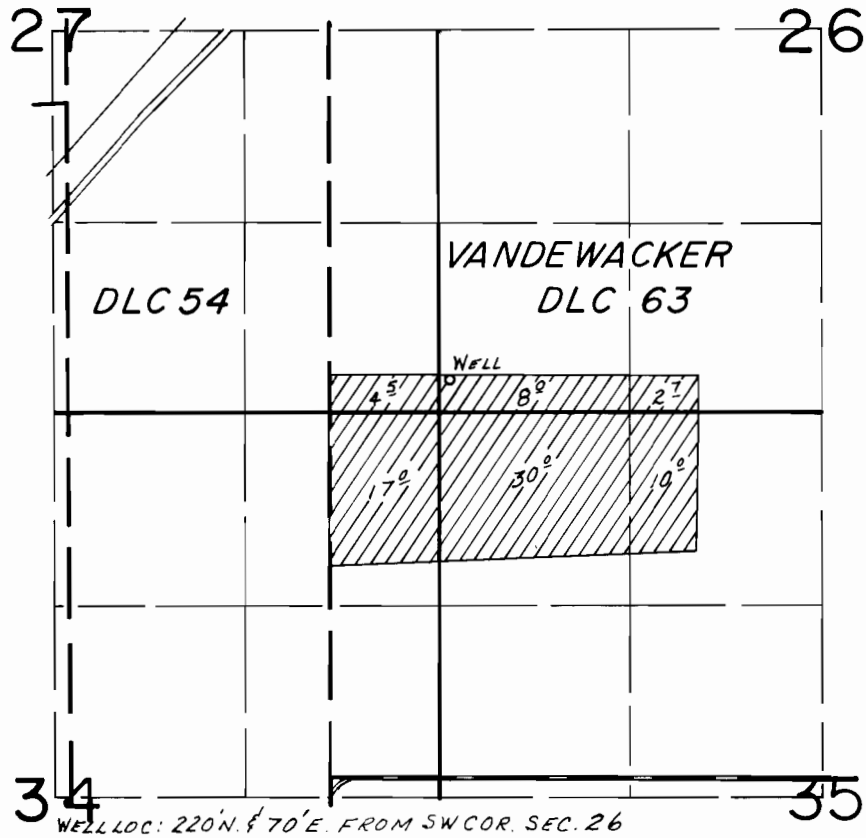

**FINAL PROOF SURVEY**  
UNDER

Application No. G-8775 Permit No. G-8128.....  
IN NAME OF

C. N. R. FARMS, INC.

Surveyed OCT. 27, 1983, by L. M. TOLL.....