


T.6S. R.2W., W.M.

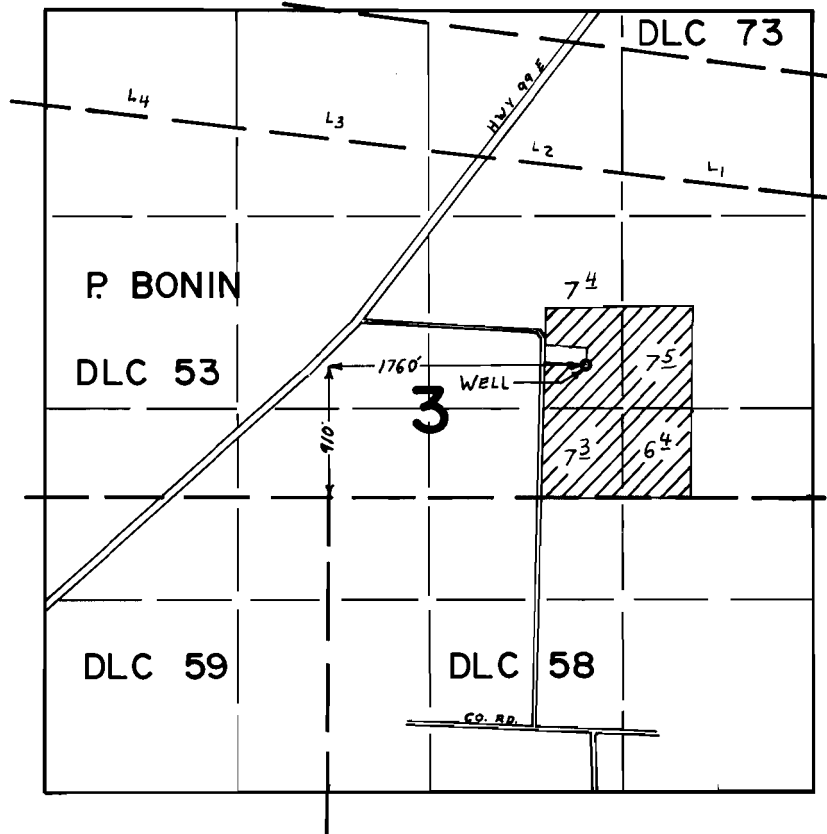

FINAL PROOF SURVEY UNDER

Application No. G-8724... Permit No. G-8318.....
IN NAME OF

.....GLORIANN R. CAUGHLIN.....

Surveyed APR. 26. 1979., by L. H. NUNN.....