


T.6S. R.2W., W.M.

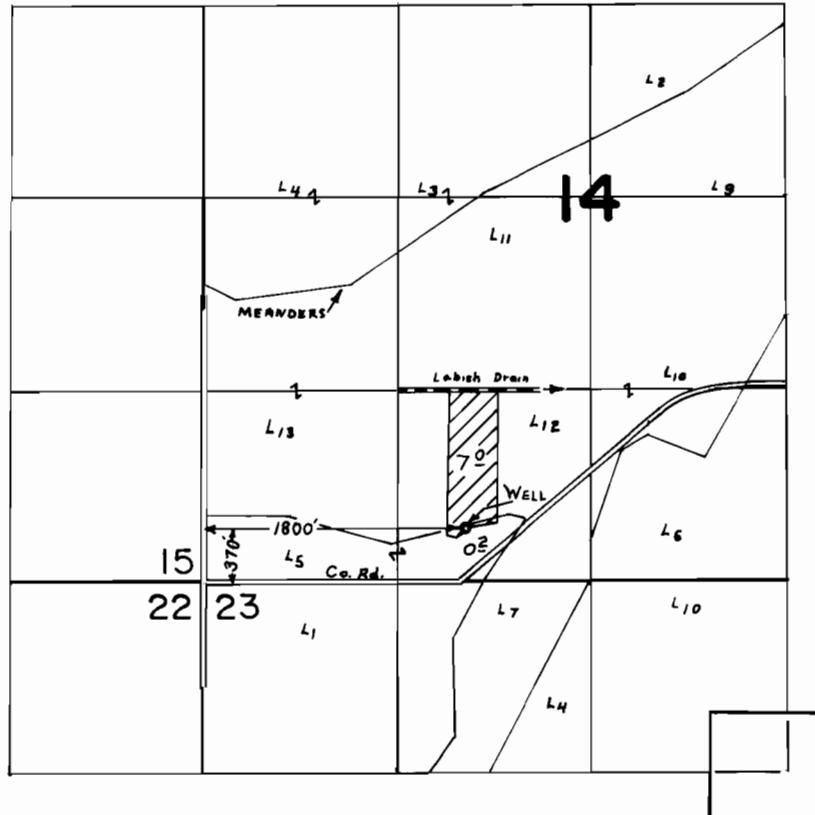

FINAL PROOF SURVEY UNDER

Application No. G-8830. Permit No. G-8414.....
IN NAME OF

.....GERALD BIGGINS.....

Surveyed APR. 25. 1979., by L. H. NUNN.....