T.2N. R.27E. W.M.

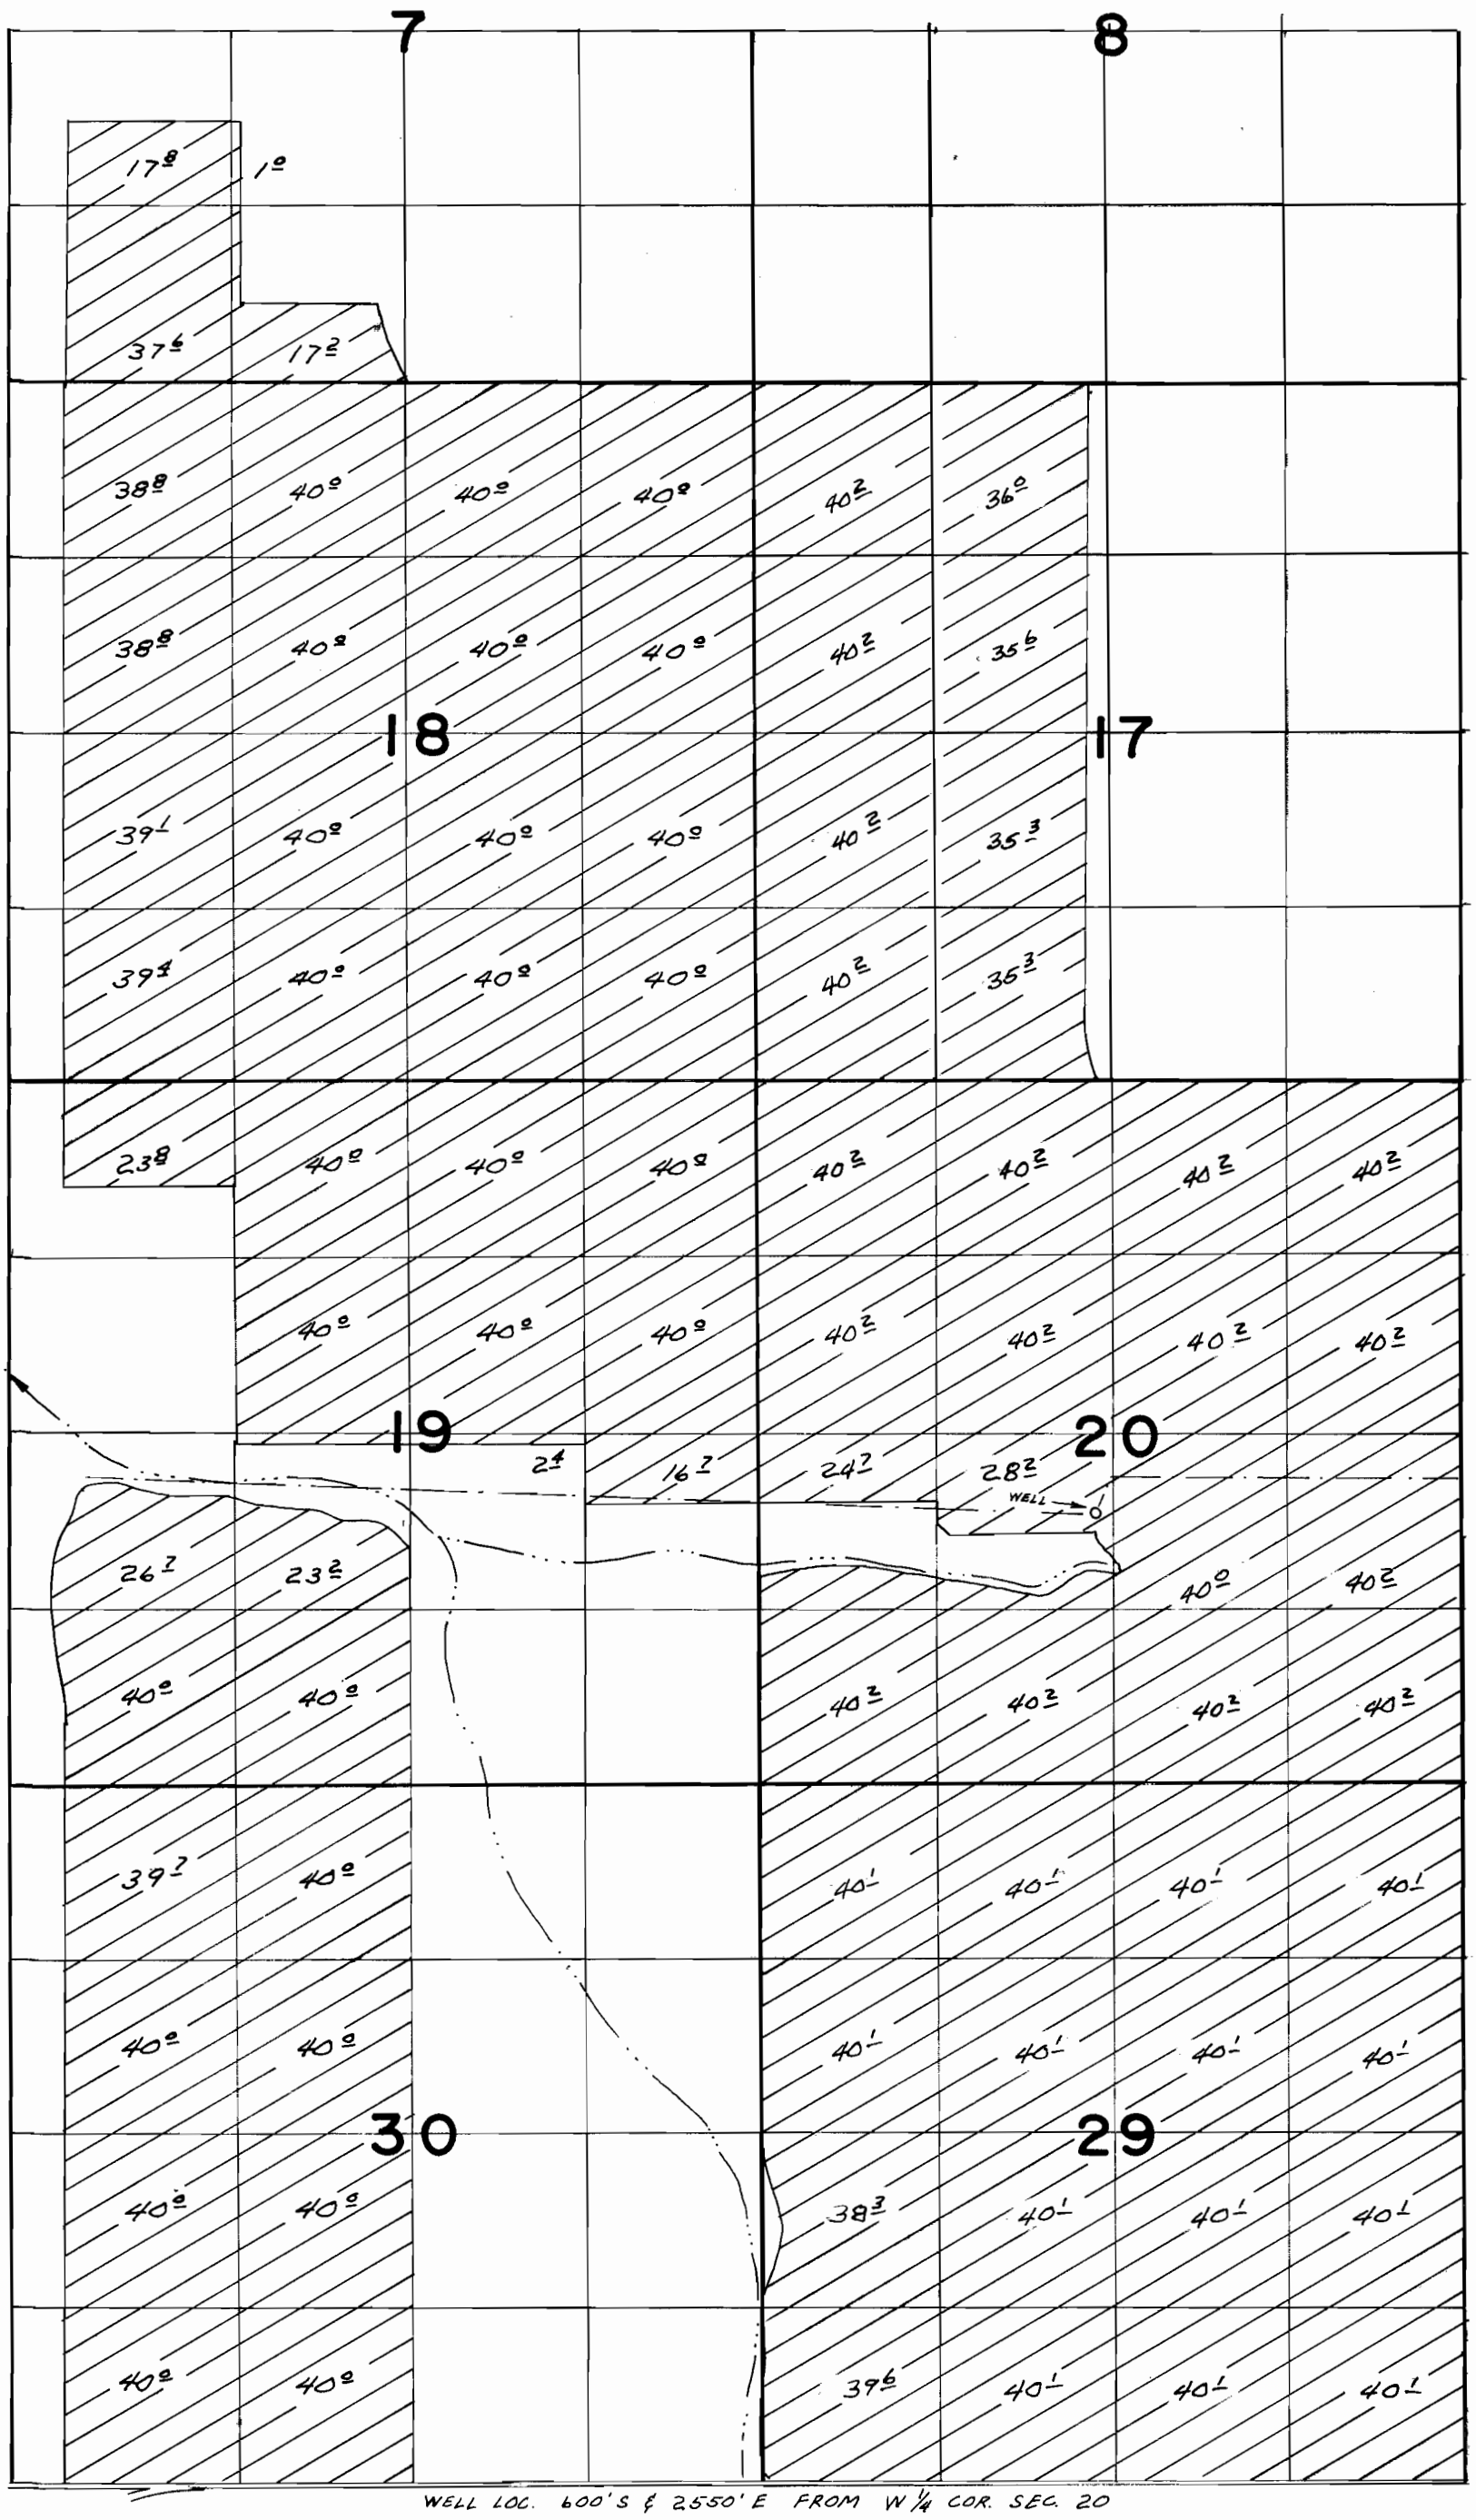

FINAL PROOF SURVEY

UNDER

APPLICATION NO. G-4726 PERMIT NO. G-4477

IN THE NAME OF

STANLEY TUCKER

SURVEYED SEP. 17, 1975 BY L.H. NUNN

41049 172-29
-36
-38