
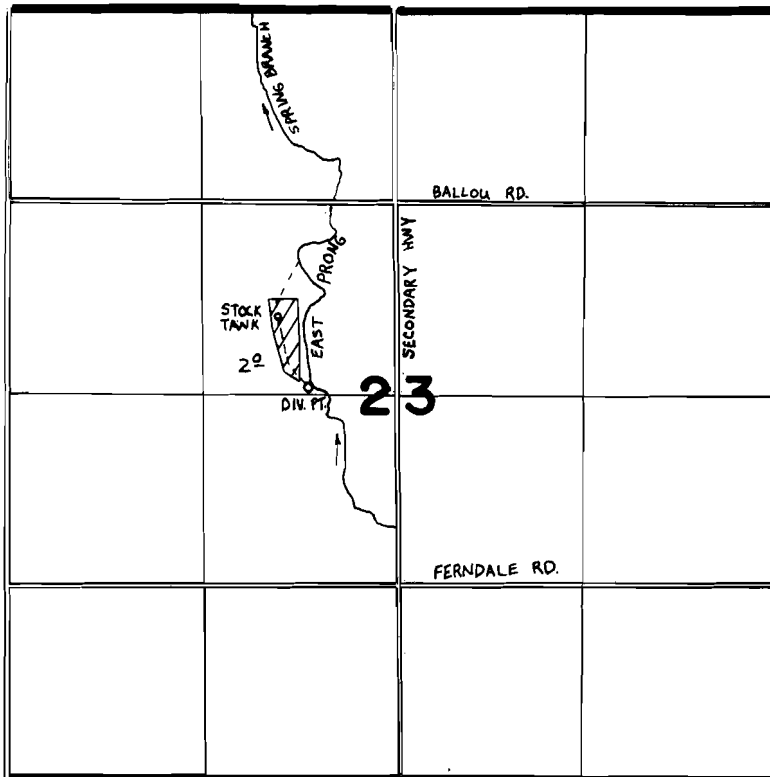


T. 6 N., R. 35 E., W. M.

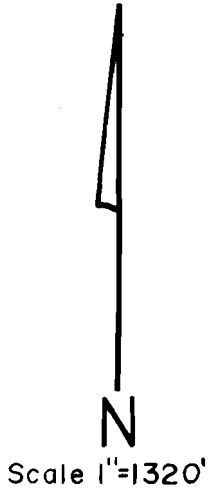

DIV. PT. LOC. 30' N. & 620' W. FROM CENTER COR. SEC. 23

FINAL PROOF SURVEY UNDER

Application No. 61447... Permit No. 45649.....
IN NAME OF

.....**BENJAMIN S. CRISP**.....

Surveyed May...9.... 1986, by J. Sauter.....