


G-8961  
56284

# T. 2N., R. 33E., W. M.

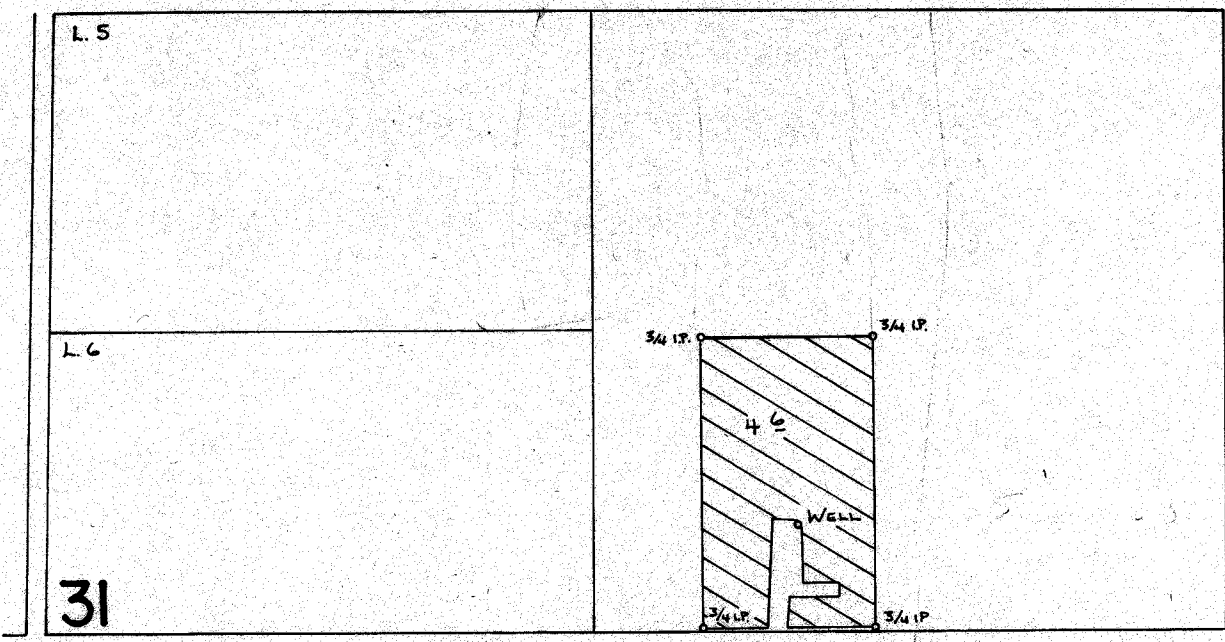

WELL LOCATED 240' N. & 1570' E. FROM SW COR. SEC 31

## FINAL PROOF SURVEY UNDER

Application No. **G:9540** Permit No. **G:8961**.....  
IN NAME OF

**JEFF L. KUBIN**

Surveyed **5..8**..... 19**84**.. by **V. L. Church**.....

SCALE: 1" = 400'

