


T. 9S., R. 40E., W. M.

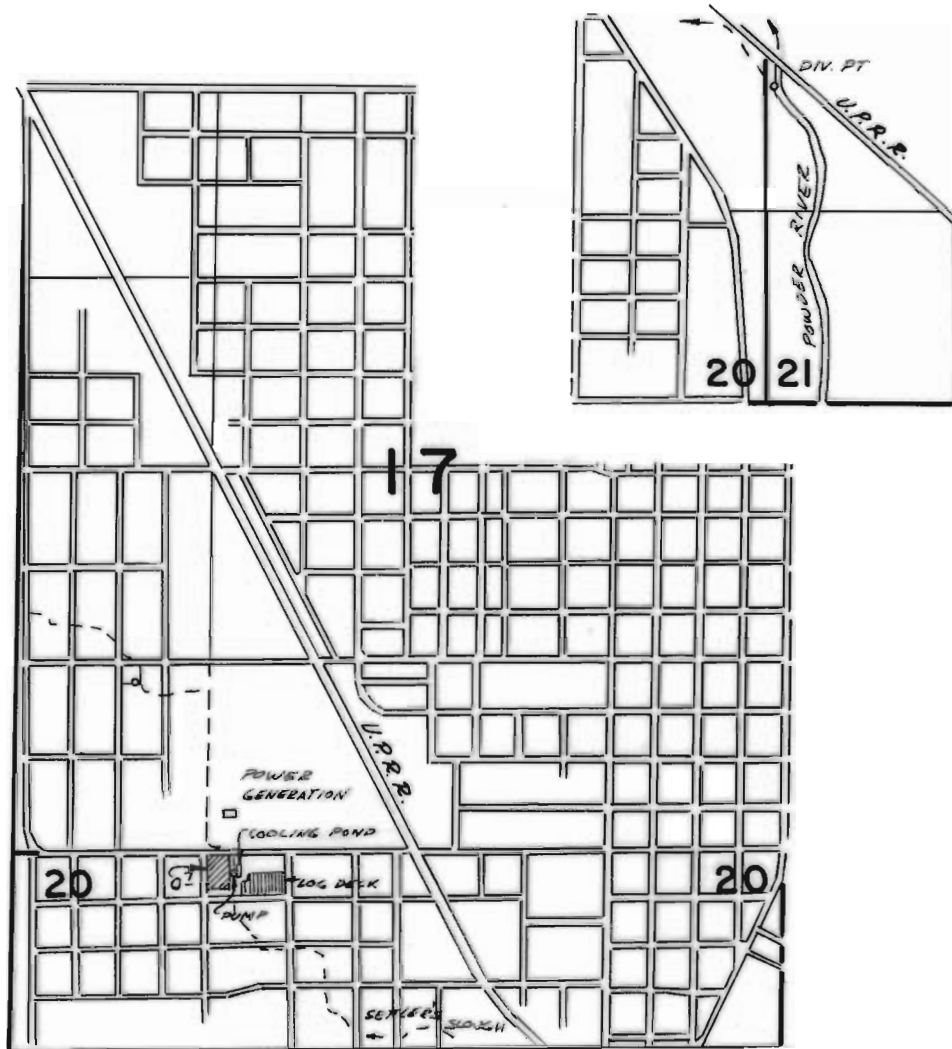

DIV. PT. LOCATED 2180' N + 53' E FROM SW COR SEC 21

FINAL PROOF SURVEY

UNDER

TRANSFER 4309

50923

37115

Application No. 59428 Permit No. 44685

IN NAME OF

ELLINGSON LUMBER CO.

Surveyed DEC 11 1981 by Vernon L. Church