
90684

T.5S., R.1E., W.M.

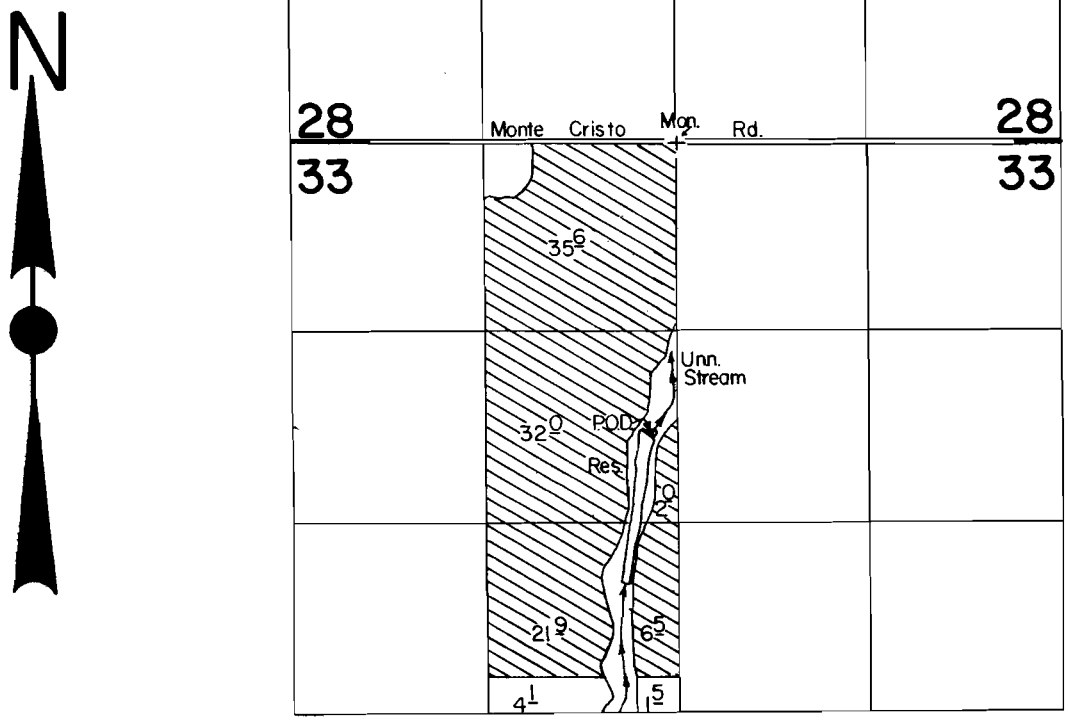

P.O.D. Loc.: 2010' S. & 190' W. from N. 1/4 Cor. Sec. 33.

Scale: 1" = 1320'

FINAL PROOF SURVEY

UNDER

R-56549 R-6658

Application No. 56550 **Permit No.** 42009

IN NAME OF

EUGENE R. SCHMITZ

Surveyed JULY 12, 1985, **by** T. Warren

41005-278-144 D

TMW