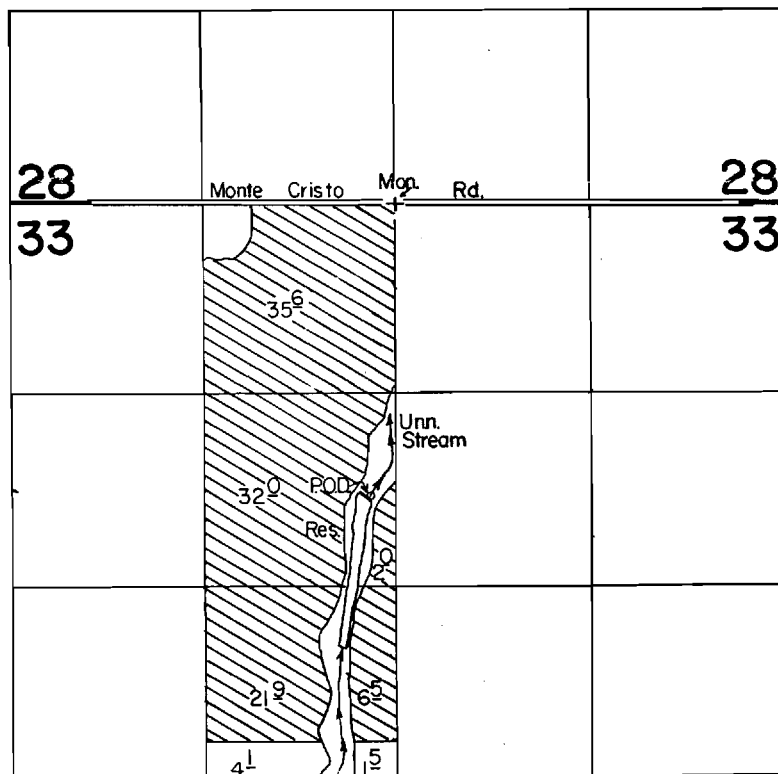


[illegible]

Scale : 1" = 1320'

R-56549

R-6658

EUGENE R. SCHMITZ

Surveyed JULY 12, 1985, by T. Warren.....

41005-278-144 D