




T. 4 S., R. 1 E., W.M.

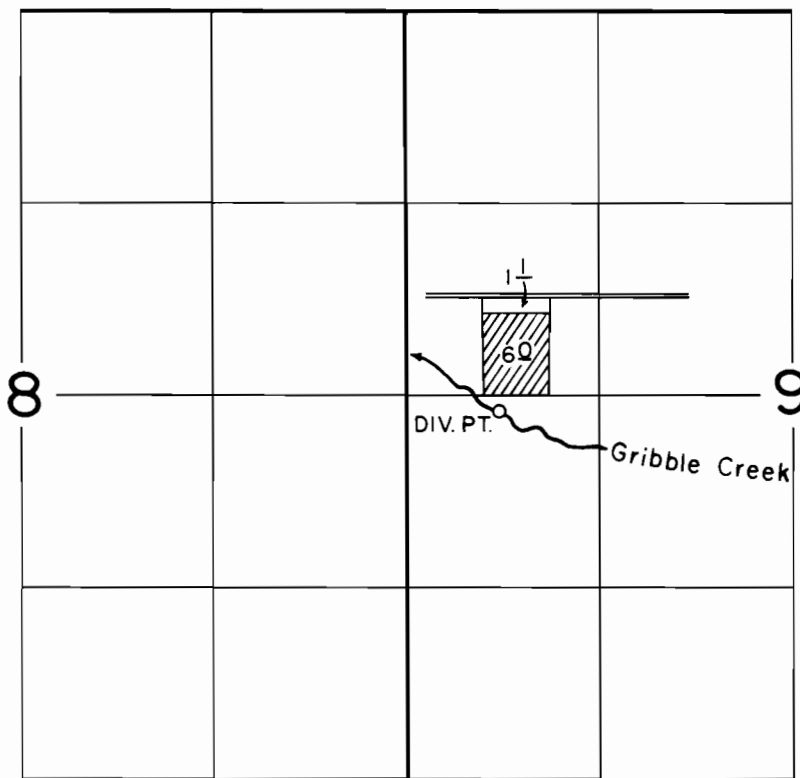

DIV. PT. LOC.: 2750' S. & 640' E. FROM THE N.W. CORNER SEC. 9

SCALE: 1" = 1320'

**FINAL PROOF SURVEY**  
UNDER

Application No. 55203. Permit No. 41517.....  
IN NAME OF

..... FRED W. EGGER .....

Surveyed JULY 10, 1985, by T. WARREN.....