




T. 3 S., R. 1 E., W.M.

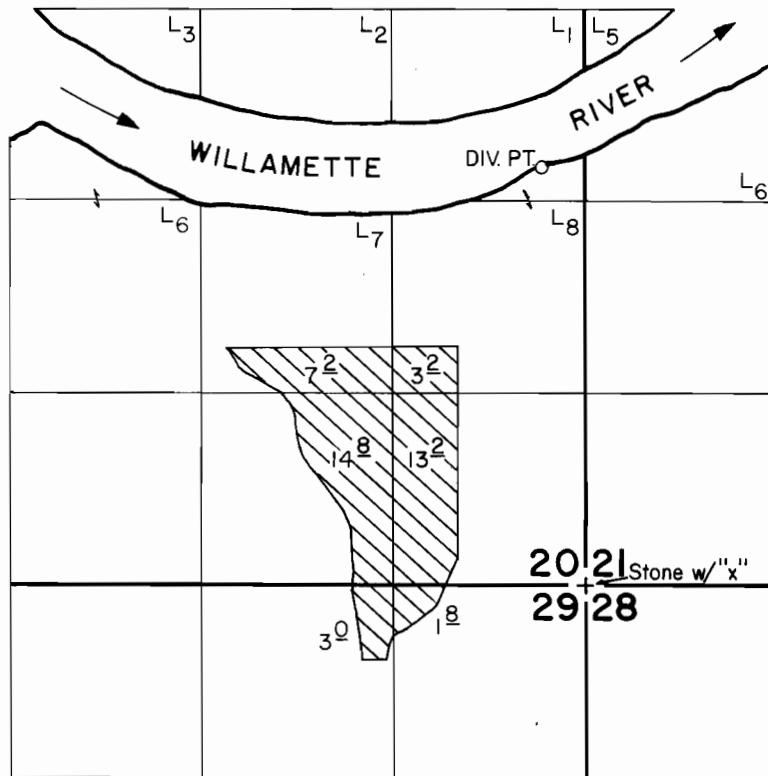

DIV. PT. LOC.: 2870' N. & 300' W. FROM S.E. CORNER SECTION 20

SCALE: 1" = 1320'

FINAL PROOF SURVEY
UNDER

Application No. 63378... Permit No. 46746.....
IN NAME OF

.....WALTER KURT SCHRADER.....

Surveyed JULY 21, 1986, by T. WARREN.....