




T. 4 S., R. 2 E., W. M

SECTION 2

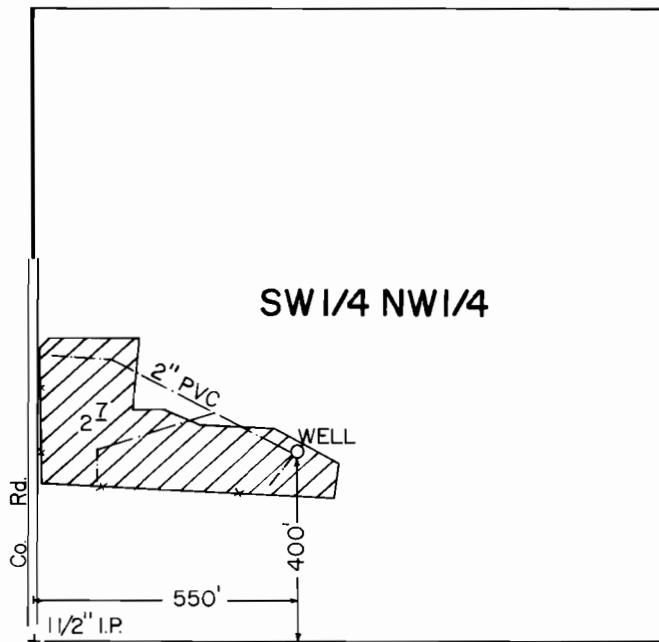

SCALE: 1" = 400'

FINAL PROOF SURVEY
UNDER

Application No. G-6613 Permit No. G-6194
IN NAME OF

ROBERT W. LEHMAN

Surveyed JULY 3, 1986, by T. WARREN