


# T.28 S., R.7 W., W.M.

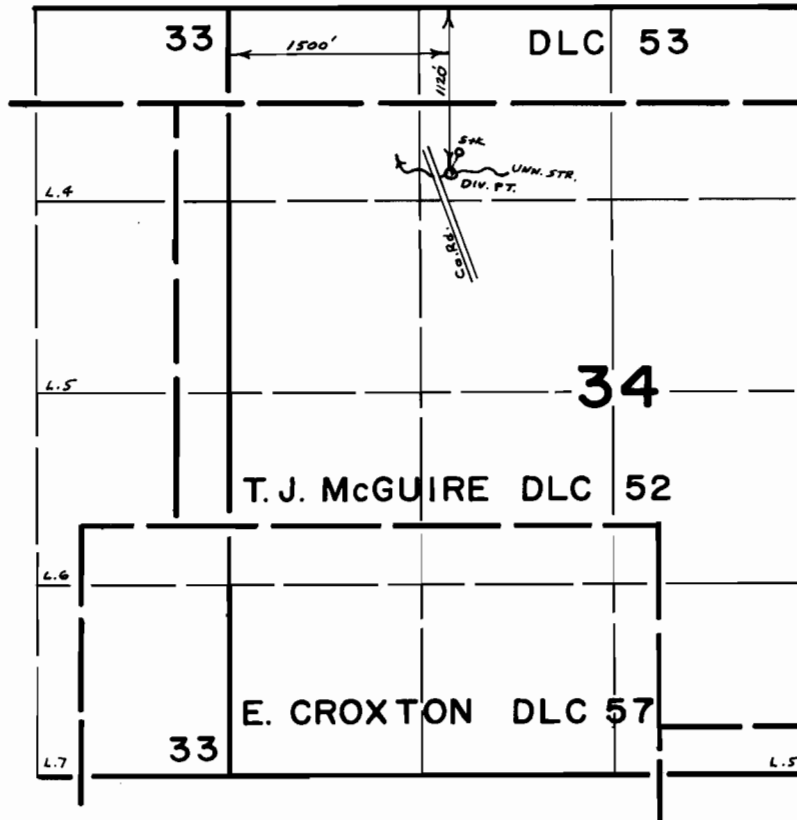

SCALE 4" = 1 mile

## FINAL PROOF SURVEY UNDER

Application No. 50403 Permit No. 38040  
IN NAME OF

ROBERT CAMAIONI

Surveyed June 4, 1979, by S. Donaldson.