


T. 26 S., R. 3 W., W. M. SECTION 10

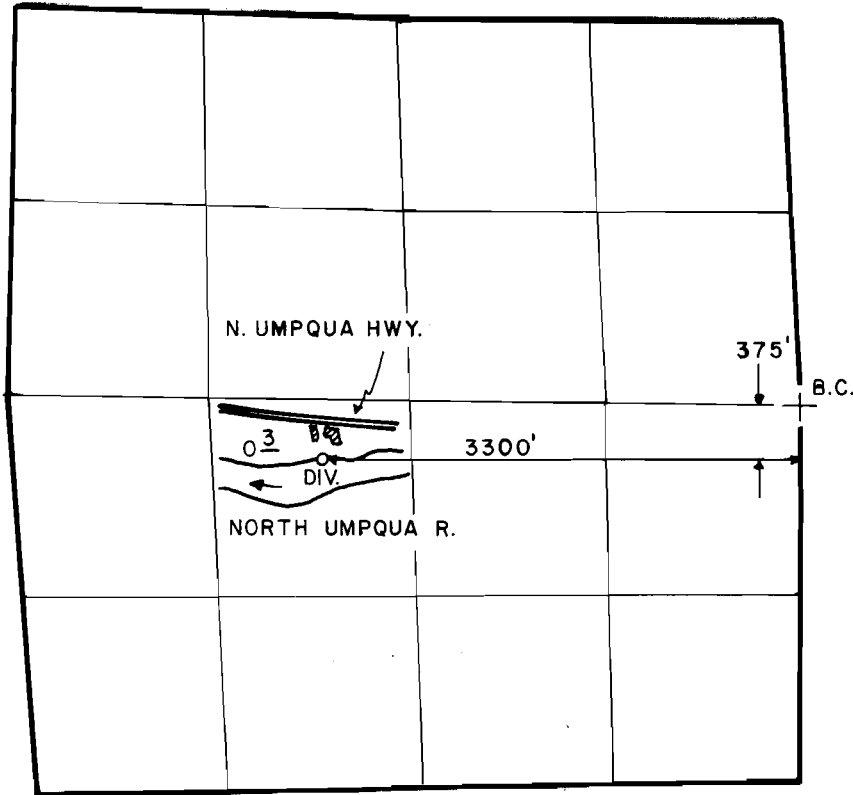

SCALE: 4" = 1 MILE

FINAL PROOF SURVEY UNDER

Application No. 61461... Permit No. 45662...
IN NAME OF

SUSAN E. SCHORTGEN

Surveyed SEPT. 5, 1985, by J.M. SCHMORDE