


T. 26 S., R. 3 W., W.M.

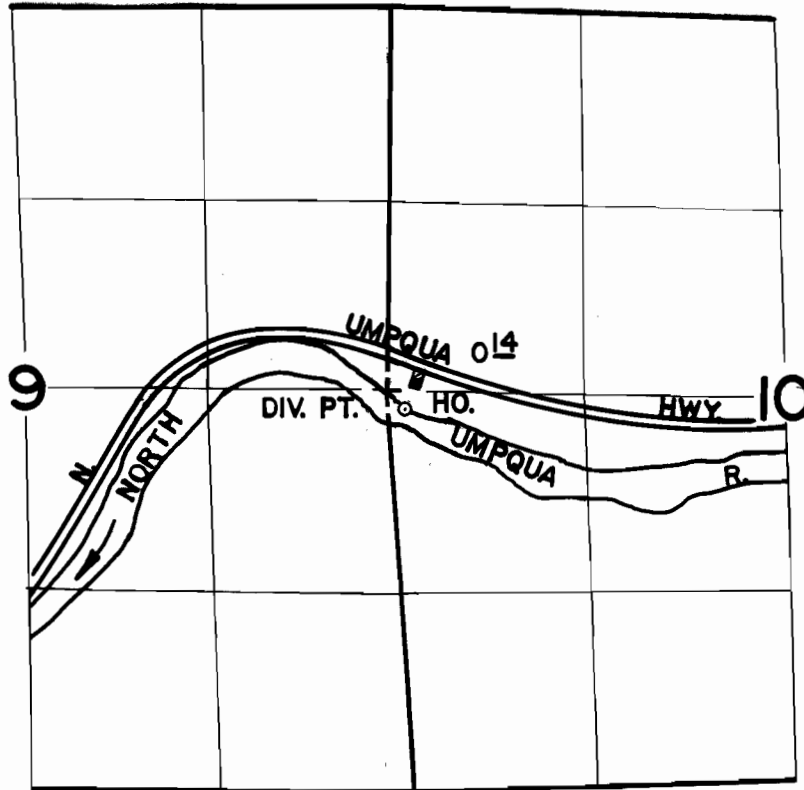

DIV. PT. IS LOCATED 150' S. & 100' E. OF W 1/4 CORNER SEC. 10

SCALE: 4" = 1 MILE

FINAL PROOF SURVEY UNDER

Application No. ...65277 Permit No. ...47678.....
IN NAME OF

.....HARVEY F. REYNOLDS.....

Surveyed .AUG..22, 19.85, by ...J.M. SCHMORDE