


T. 26 S., R. 3 W., W.M.

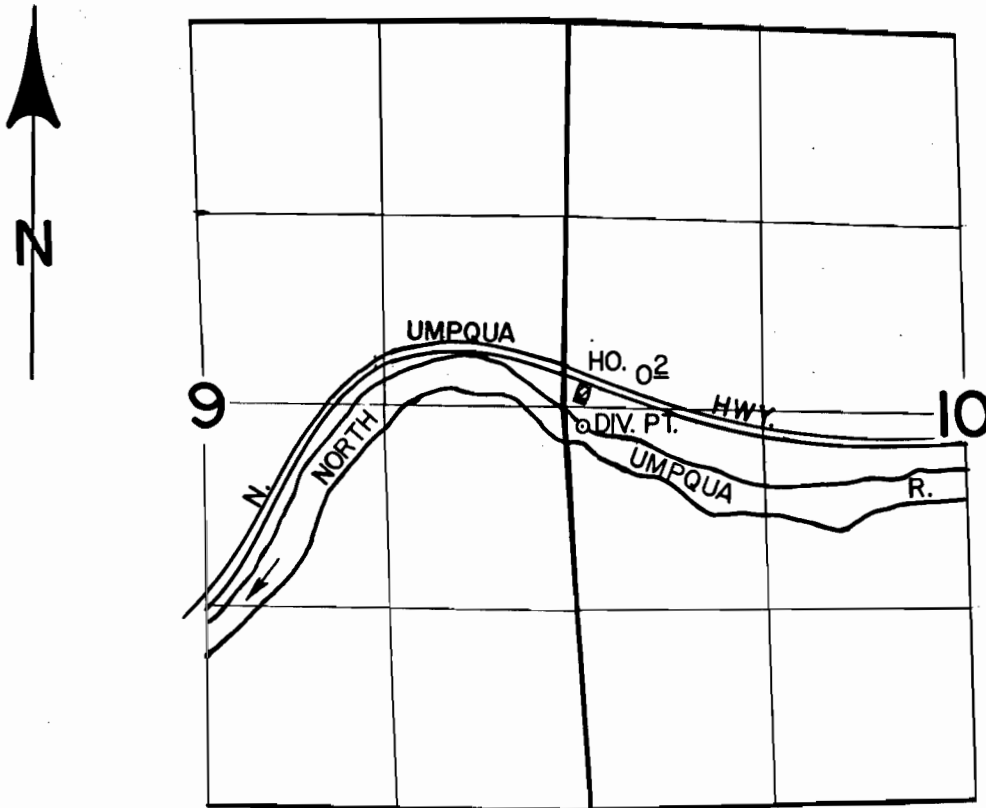

DIV. PT. IS LOCATED 150' S. & 100' E. OF W 1/4 CORNER SECTION 10

SCALE: 4" = 1 MILE

FINAL PROOF SURVEY UNDER

Application No. ...~~65484~~ Permit No. ...47964.....
IN NAME OF

ARTHUR I. & FLOSSIE.....IRENE...KNIGHT

Surveyed .SEPT..5, 19.85, by ..J.M..SCHMORDE