


T.13 S. R. 31 E. W.M.

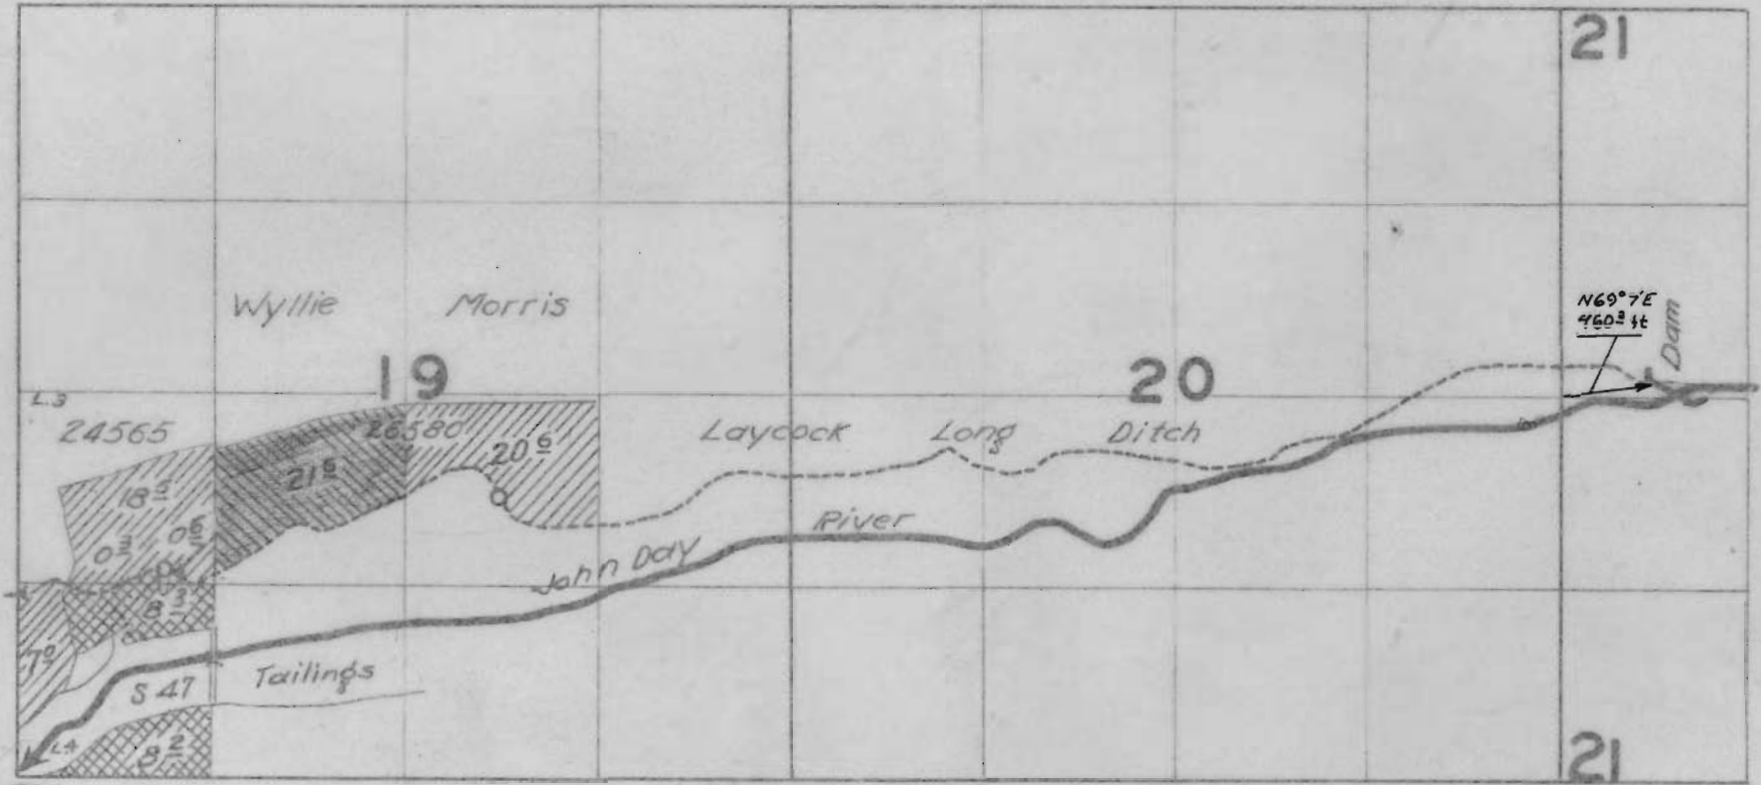

FINAL PROOF SURVEY

Application No. 26580 Permit No. 20824  
 24565 19367

Application No. 32157  
 Permit No. 25370

Trus. .... John Silvers & James A. Wyllie & Clark Morris  
 Surveyed Aug. 27-28, 1954 by H. L. Coffman & T. Jones