P- 31233
S6306

T. 12S, R.33 & 34E.W.M.

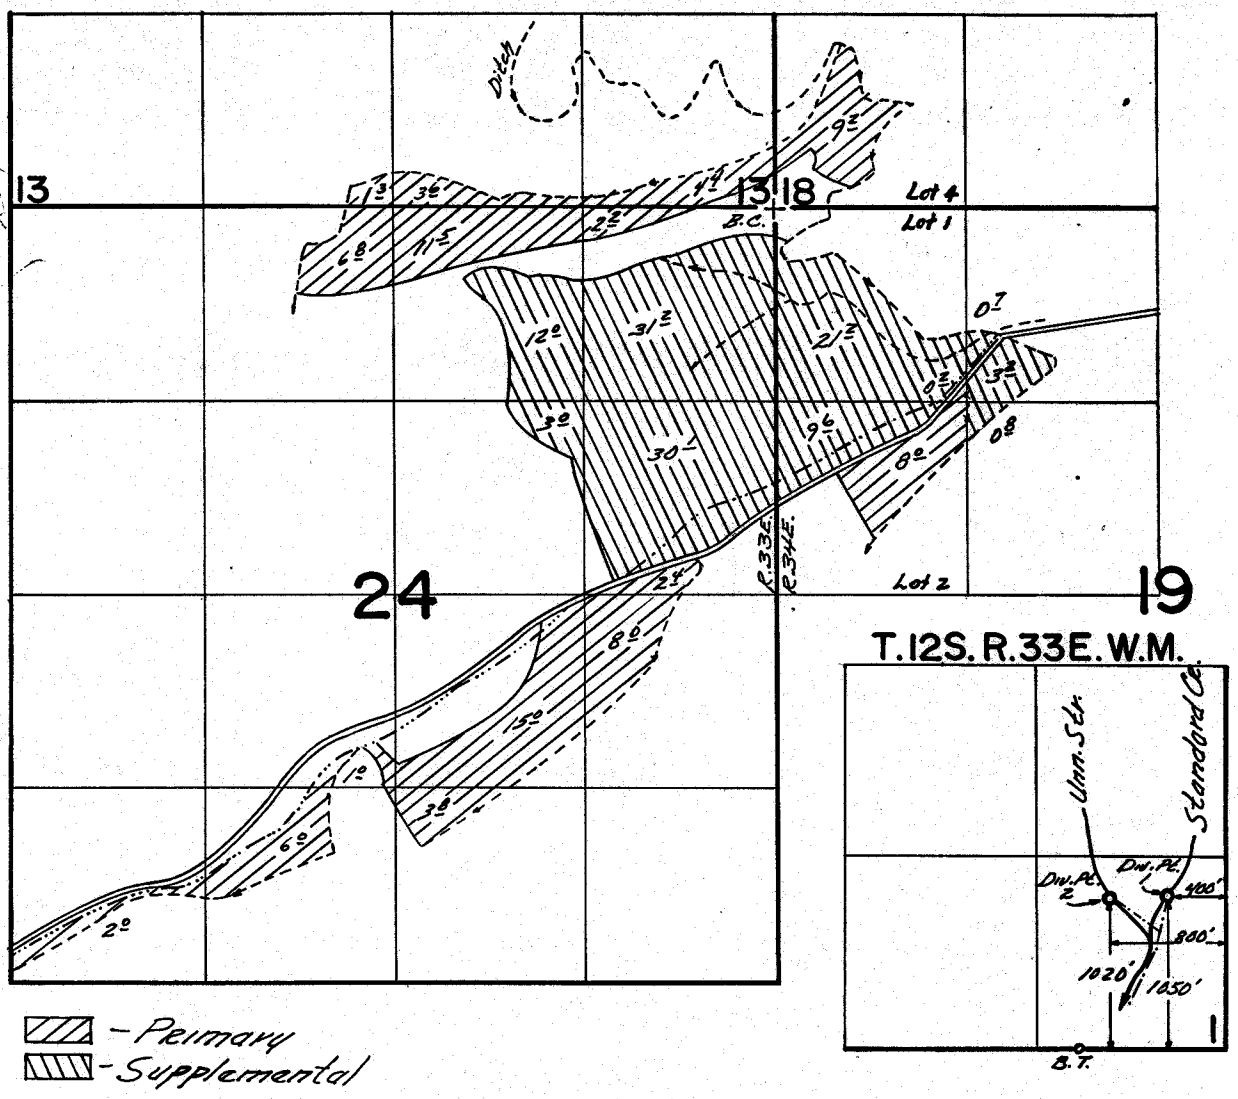

FINAL PROOF SURVEY

UNDER

Application No. 42293.. Permit No. 31233.....
IN NAME OF

ERNEST RICCO

Surveyed July 17 1979., by S.C. BROWN

PTS-1979-8-63-10 / #41023A-1576-61