


P- 36849  
C- 56307

T. 13S., R. 28E., W.M.

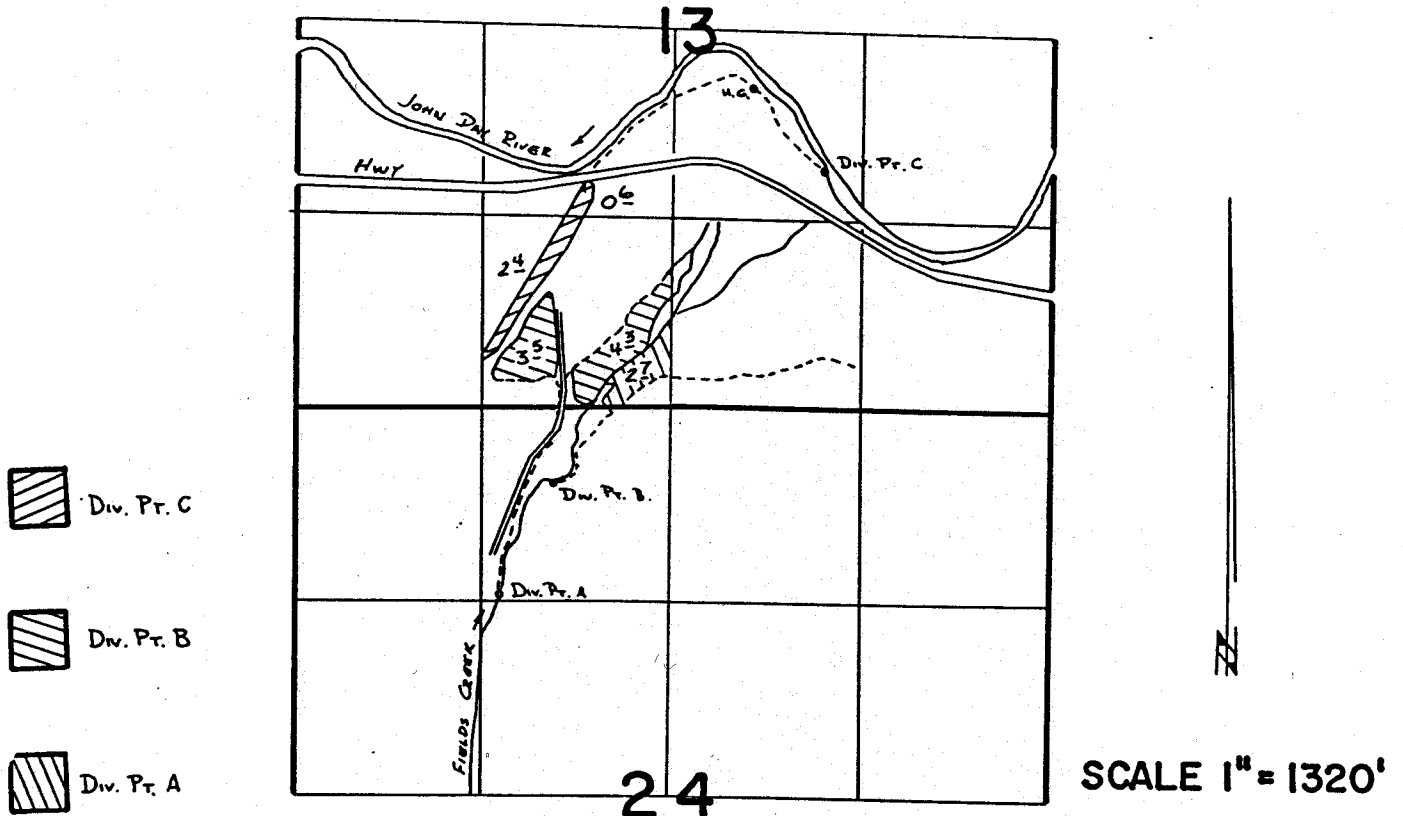

Div. Pr. A Loc: 1270'S. & 1180'W.  
Div. Pr. B Loc: 510'S. & 800'W.  
Div. Pr. C Loc: 1600'N. & 1050'E. } FROM S<sup>1</sup>/<sub>4</sub> COR. SEC 13

**FINAL PROOF SURVEY**  
UNDER

Application No. **49143** Permit No. **36849**  
IN NAME OF

**SMOKEY OVERTON**

Surveyed **3-21** 19**86**, by **V. L. Church**