


P-38310
C-56308

T.13S. R.30E.W.M.

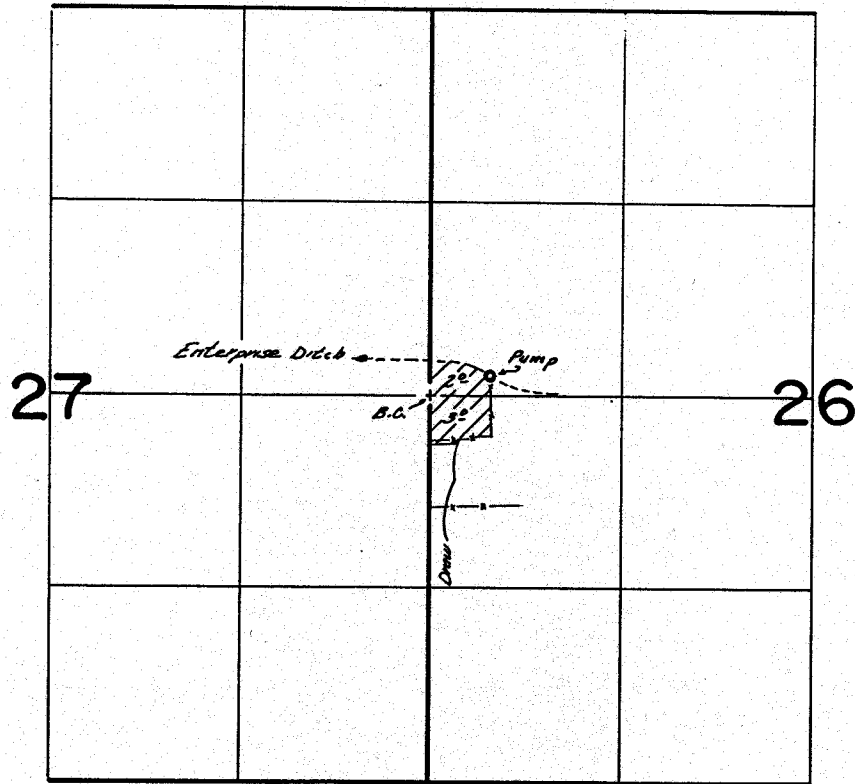

Div. Pl. Loc. 1700' N, 1700' E from SW Cor. Sec. 20, T.13S. R.31E.

FINAL PROOF SURVEY
UNDER

Application No. 50720.. Permit No. 38310.....
IN NAME OF

.....**P.G. ULIBARRI**.....

Surveyed Sept. 17.. 1979., by **S.C. BROWN**.....