


42604
56309



T. 13S., R. 29E., W. M.

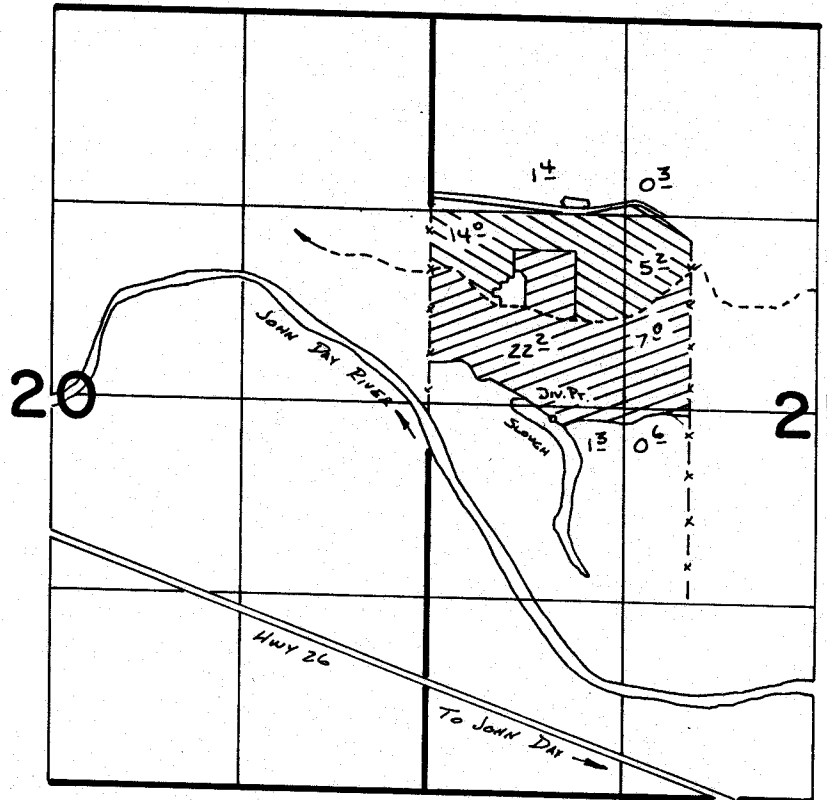

SCALE 1" = 1320'

Div. Pt. Loc: 2570' N. + 840' E. FROM SW COR. SEC 21

FINAL PROOF SURVEY
UNDER

 PRIM.
 SUPPL.

Application No. ~~56781~~.. Permit No. **42604**..
IN NAME OF

.....**RICHARD L. & LOETA M. MILLER**.....

Surveyed ...~~4-24~~..... 19~~86~~**86**., by ~~V. L. Church~~.....