


T. 12S., R. 34E., M.W.

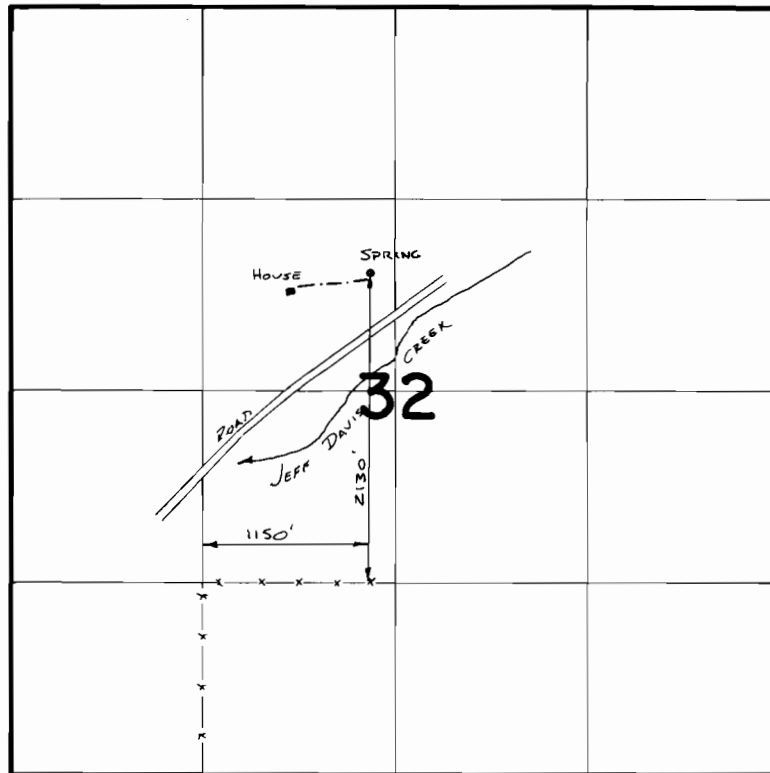

SCALE 1" = 1320'

FINAL PROOF SURVEY
UNDER

Application No. **58524** Permit No. **44103**
IN NAME OF

B. D. CLINE

Surveyed 3-18 1986, by L. M. Tate