



P-45295  
C-56311

# T. 15 S. R. 32 E. W.M.

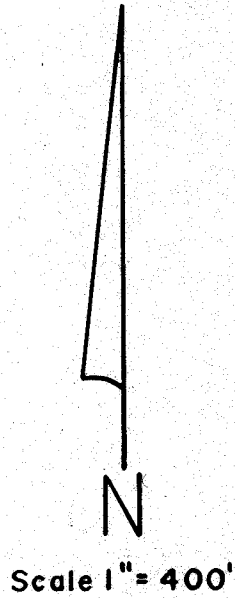

## SW 1/4 SE 1/4 SECTION 28

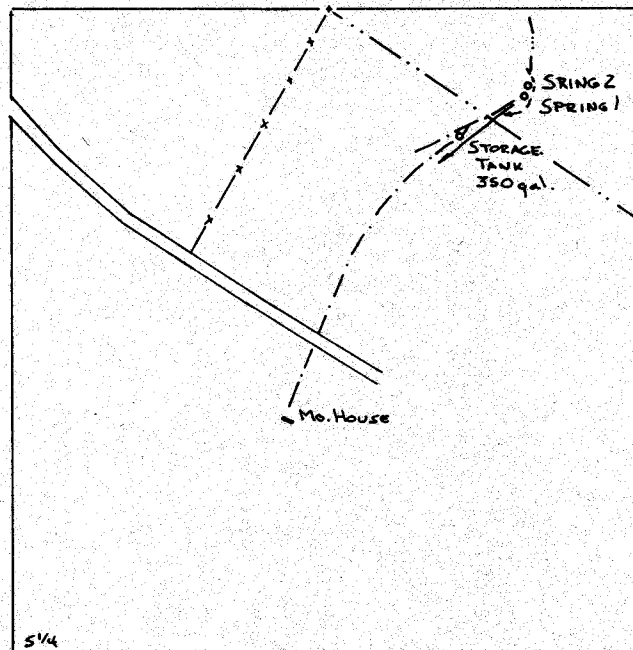

SPRING 1 Loc: 1140' N. + 1070' E. } FROM S 1/4 COR. SEC 28  
SPRING 2 Loc: 1160' N. + 1080' E. }

### FINAL PROOF SURVEY UNDER

Application No. 60520. Permit No. 45295.....  
IN NAME OF

.....**REX MOLES**.....

Surveyed April..9... 1986, by J.M.T.O.J.....