


P-46342

C-56312

T. 18S., R. 28E., W. M.

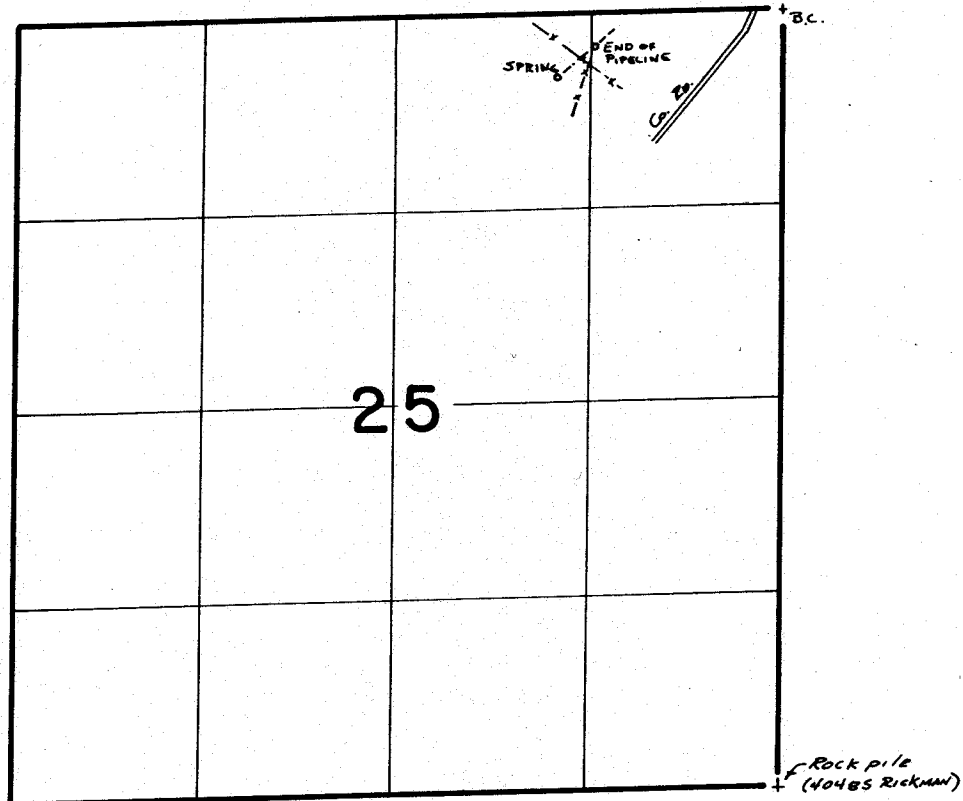

SCALE 1" = 1320'

SPRING LOC: 430'S. & 1550'W. FROM NE COR. SEC. 24

FINAL PROOF SURVEY
UNDER

Application No. **62039** Permit No. **46342**
IN NAME OF

RICKMAN RANCHES, INC.

Surveyed **4-8-1986**, by **L.M. Telle**

PTS-1986 VA

VLC