


P-47601
C-56313

T. 15S., R. 31E., W.M.

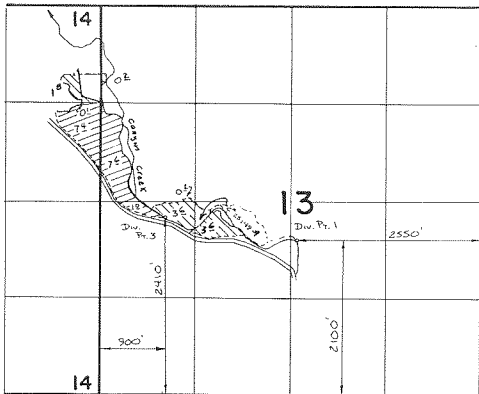

FINAL PROOF SURVEY
UNDER



Application No. 64969 Permit No. 47601...
IN NAME OF

L. J. & ELLA BAUCUM

Surveyed 4-22 1986, by L. M. Tall.....

SCALE 1" = 1320'