
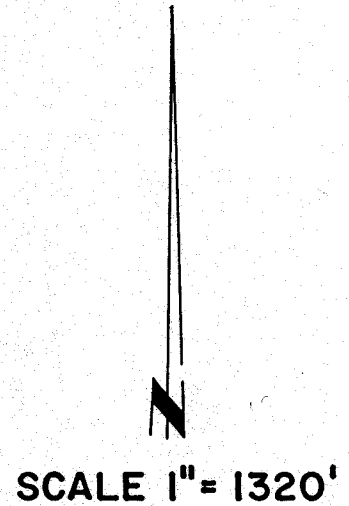
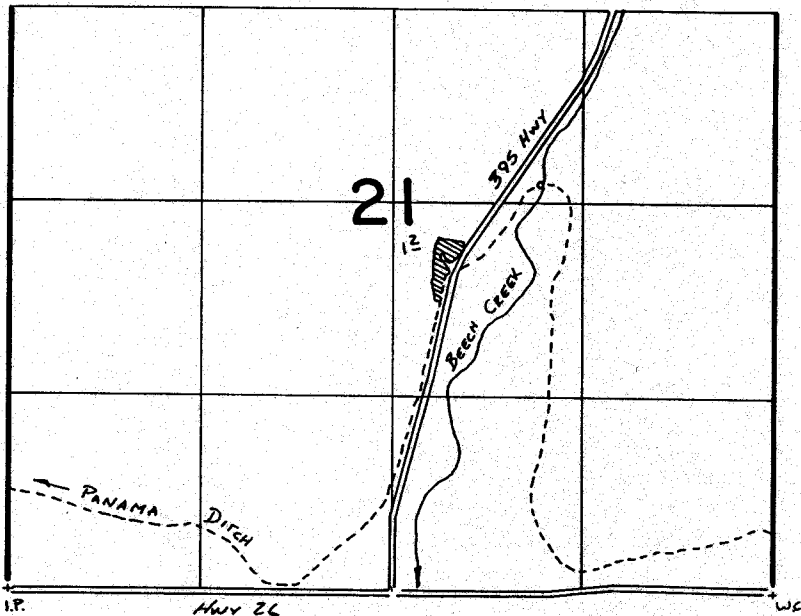


P-48088  
C-56315

T. 13S., R. 30E., W. M.

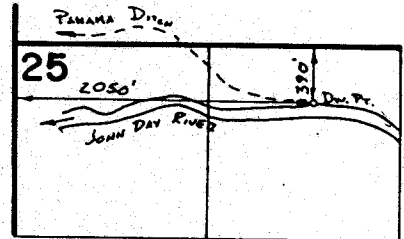

**FINAL PROOF SURVEY**  
UNDER

Application No. **67443** Permit No. **48088**  
IN NAME OF

**BARBARA & GERALD MESSERSCHMIDT**

Surveyed **3-19-1986**, by **V. Church**