


48208  
C-56318

T. 13S., R. 30E., W. M.

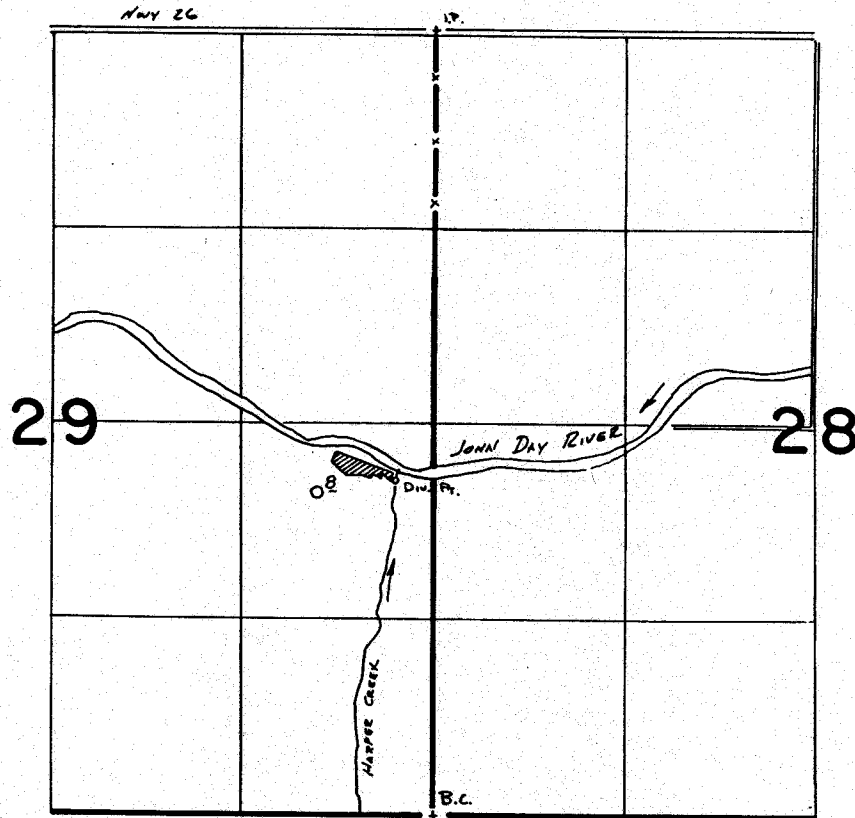

SCALE 1" = 1320'

Div. Pt. Loc: 2270' N. & 260' W. FROM SE COR. SEC 29

**FINAL PROOF SURVEY**  
UNDER

Application No. **67709** Permit No. **48208**  
IN NAME OF

**DAVE & JOANN TRIPP**

Surveyed **3-20** 19**86**, by **V. L. Church**