


T.23S.,R.33E.,W.M.

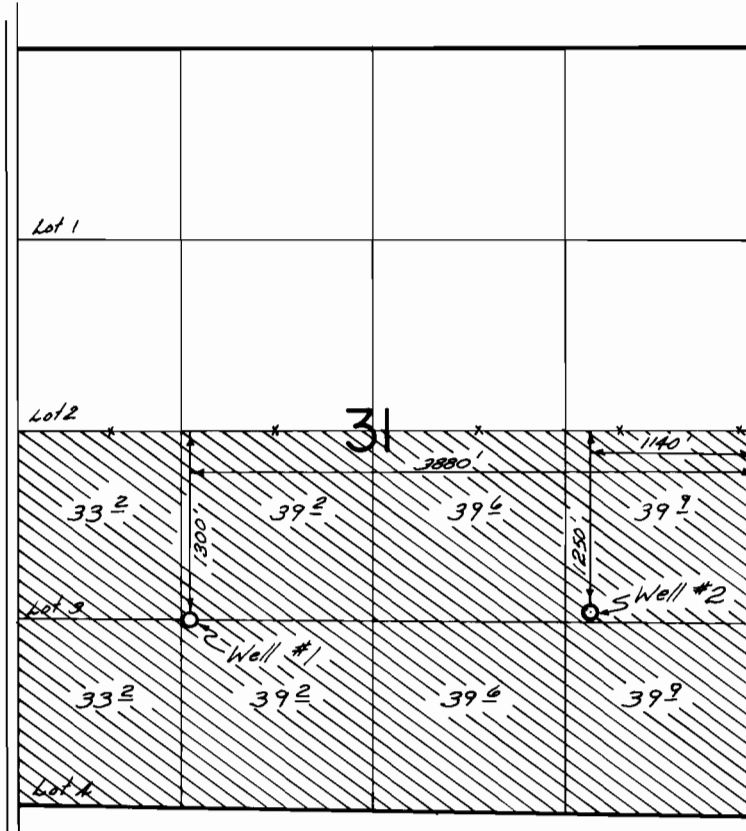

FINAL PROOF SURVEY

UNDER

Application No. G-8173, Permit No. G-7695
IN NAME OF

Donald E. Jorgensen

Surveyed AUG. 27, 1979, by R.G. MUCKEN

PTS-1979-41 *LB*