


T. 35S., R. 4 W., W.M.

Sec. 10

SE 1/4 SE 1/4

EAST EVANS CREEK RD.

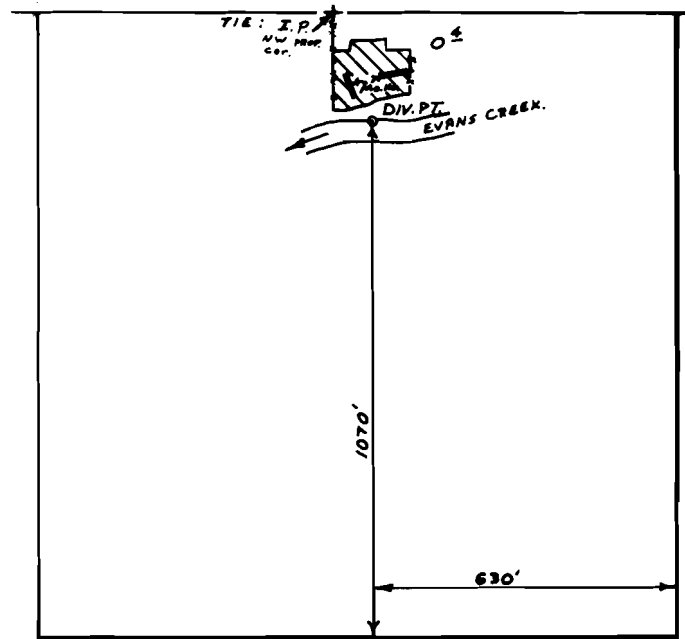

Scale: 1" = 400'

FINAL PROOF SURVEY
UNDER

Application No. 53520. Permit No. 40060.....
IN NAME OF

.....EDWARD & SANDRA FIESE.....

Surveyed August 7, 1980., by B.R. SUND.....