


T.34S., R.3W., W.M.

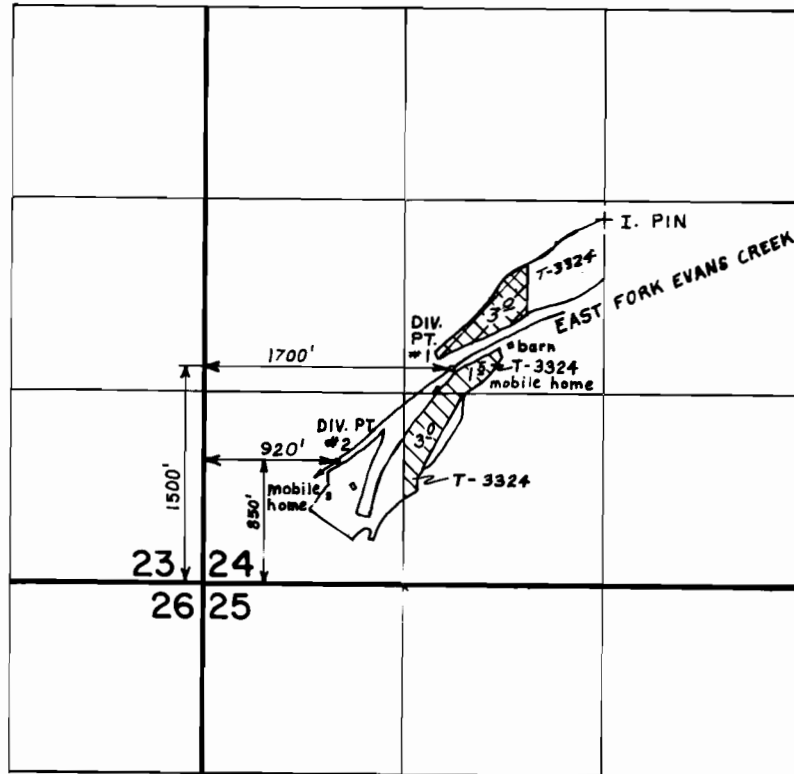

Scale: 4" = 1 mile

☒ PERMIT

☒ T-3324

FINAL PROOF SURVEY

UNDER

TRANSFER NO. 3324

Application No. 53712.. Permit No. 40152.....

IN NAME OF

ROBERT M. STOREY & OR RAYMOND G. EDHOLM

Surveyed Sept. 10, 1982, by Bruce R. Sund