



T. 38 S., R. 4 W., W.M.

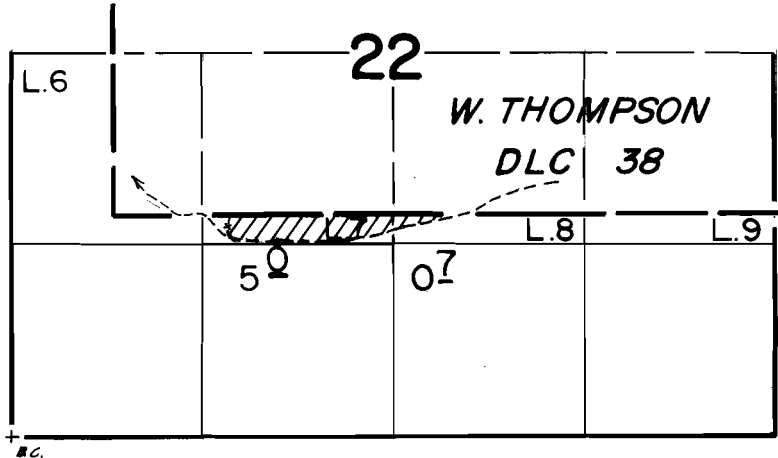

Scale 1" = 400'

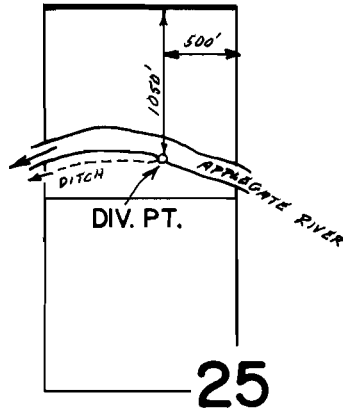

FINAL PROOF SURVEY
UNDER

Application No. 62258 Permit No. 46084
IN NAME OF

GEORGE B. & or NANCY J. STURM

Surveyed Aug. 8, 1985, by B.S. JAMES